

PLAT OF SURVEY

LEGAL DESCRIPTION:
A PARCEL OF LAND LOCATED IN THE SOUTHEAST 1/4 OF THE SOUTHEAST 1/4 OF SECTION 26 IN TOWNSHIP 2 NORTH, RANGE 17 EAST, IN THE CITY OF LAKE GENEVA, WALWORTH COUNTY, WISCONSIN.

MORE PARTICULARLY DESCRIBED AS:
LOT109 OF COLUMBIAN SUBDIVISION AS RECORDED IN DOCUMENT NO. P123512 PER THE WALWORTH COUNTY REGISTER OF DEEDS

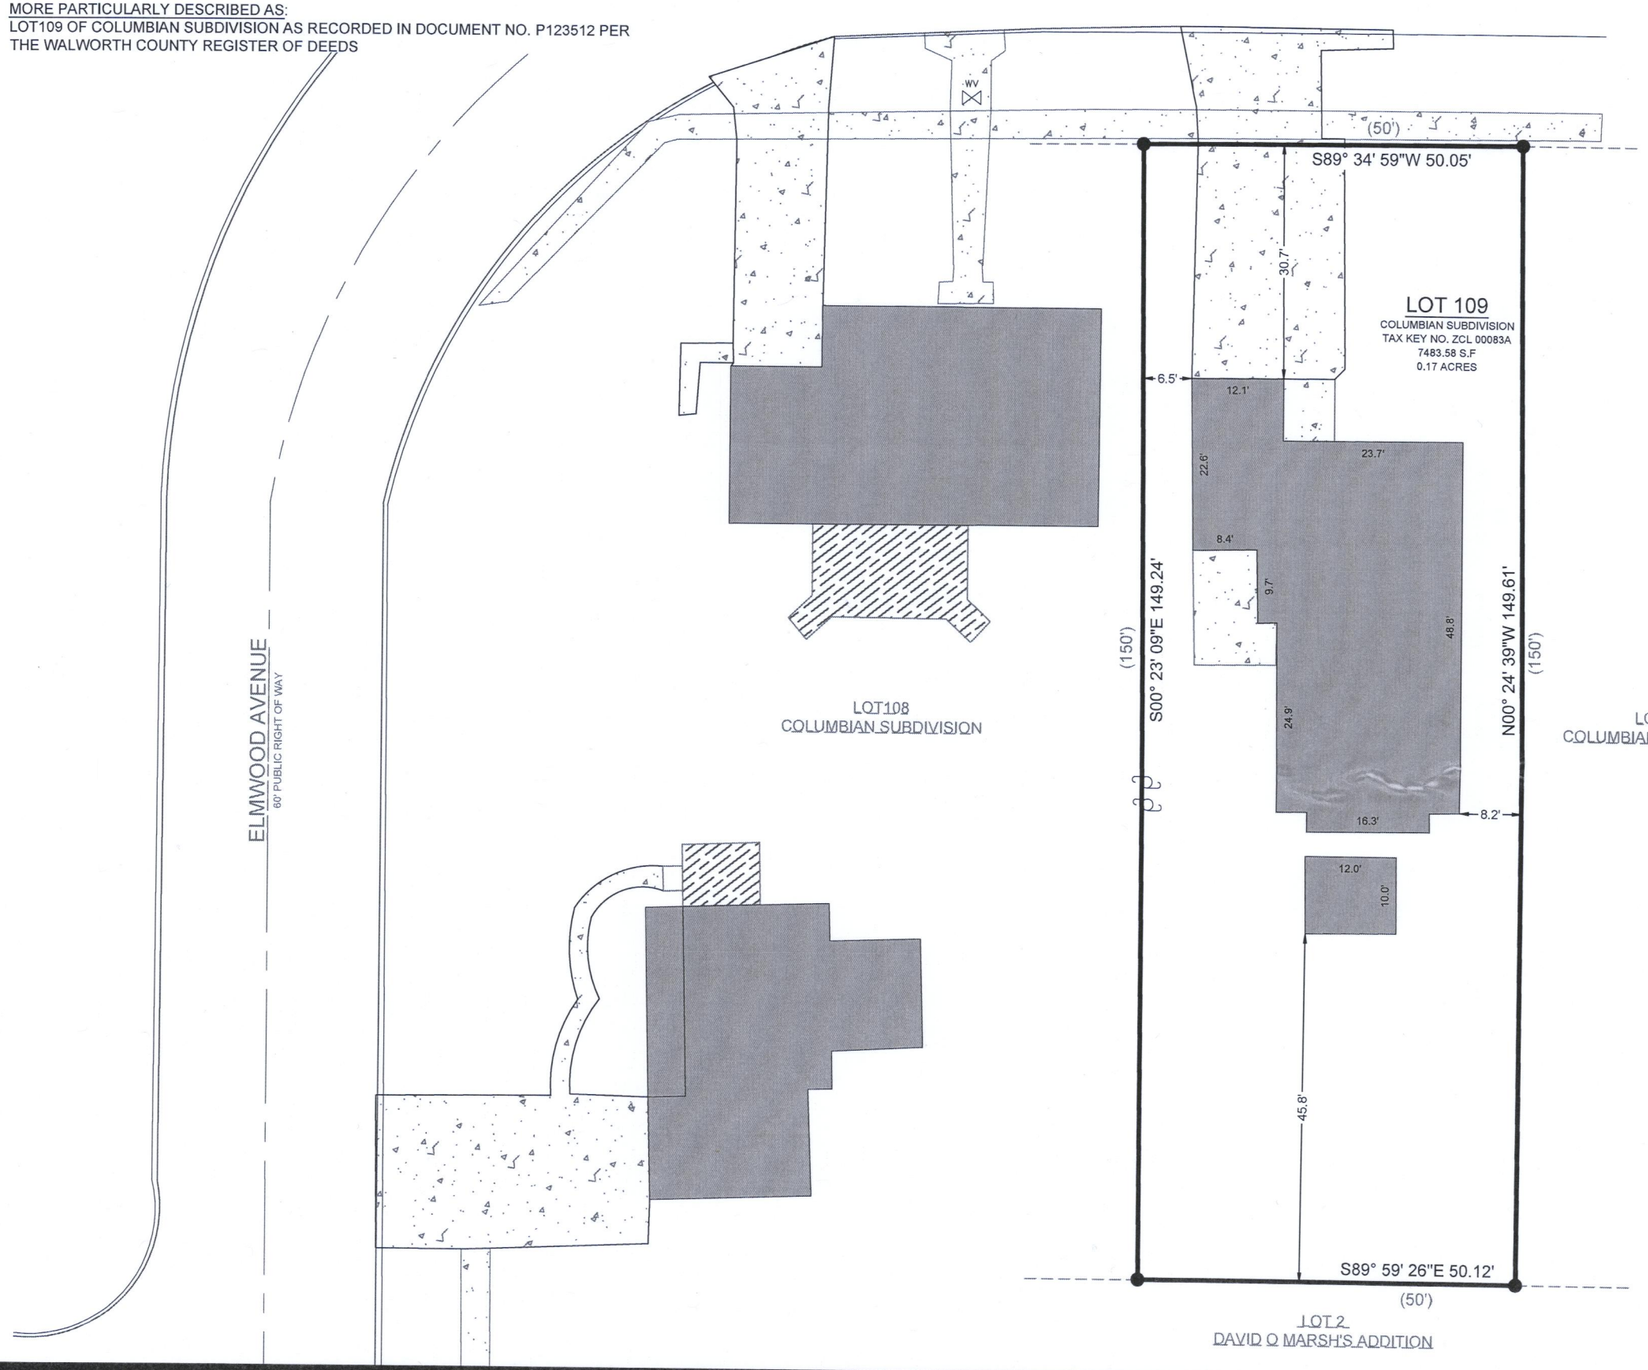

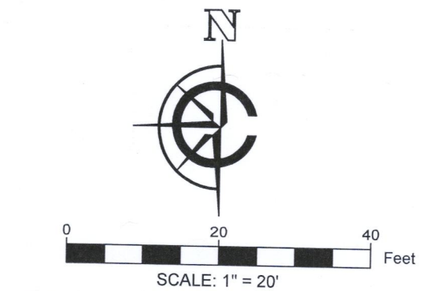

LEGEND

- EXISTING BUILDING
- EXISTING ASPHALT
- EXISTING CONCRETE
- EXISTING DECK
- (xx) RECORDED AS
- FOUND 1" IRON PIPE
- UTILITY POLE
- WV WATER VALVE

RECEIVED
NOV 29 2021
By

NOTE:

1. BASIS OF BEARING:
   THE WISCONSIN STATE PLANE COORDINATE SYSTEM, NAD-83, SOUTH ZONE.
2. FIELD WORK COMPLETED ON:
   NOVEMBER 12, 2021
3. BUILDING SURVEYED TO:
   THE EXTERIOR OF SIDING.
4. FIELD CREW CHIEF:
   RAYMOND MCARDLE

SURVEY ORDERED BY:
SUSAN RAIA

PROPERTY ADDRESS:
1330 PARK ROW
LAKE GENEVA WI, 53147

SURVEYOR:
PAUL H. VAN HENKELUM, PLS
CARDINAL ENGINEERING LLC

WISCONSIN
PAUL H. VAN HENKELUM
S-1931
LAKE GENEVA, WI
LAND SURVEYOR
11/17/2021

"I HEREBY CERTIFY THAT I HAVE SURVEYED THE ABOVE DESCRIBED PROPERTY AND THE MAP IS A TRUE AND CORRECT REPRESENTATION OF ITS EXTERIOR BOUNDARIES AND SHOWS THE SIZE AND LOCATION OF ALL VISIBLE STRUCTURES, APPARENT EASEMENTS AND ENCROACHMENTS, IF ANY.

Paul H. VanHenkelum 11/17/2021

PAUL H VAN HENKELUM, PLS #1931 *DATE*

CARDINAL ENGINEERING LLC
DESIGNING IN TRUE DIRECTIONS

PO BOX 281 - 1200 LA SALLE ST.
LAKE GENEVA, WI 53147
262-757-8776
CARDINALENGINEERINGWI.COM

DATE: 11 / 17/ 2021 JOB No. 21555
SHEET 1 0F 1 LWG

PLOTTED: 11/17/2021 10:18:08 AM

ZCL-83A

007-3915