
61-6

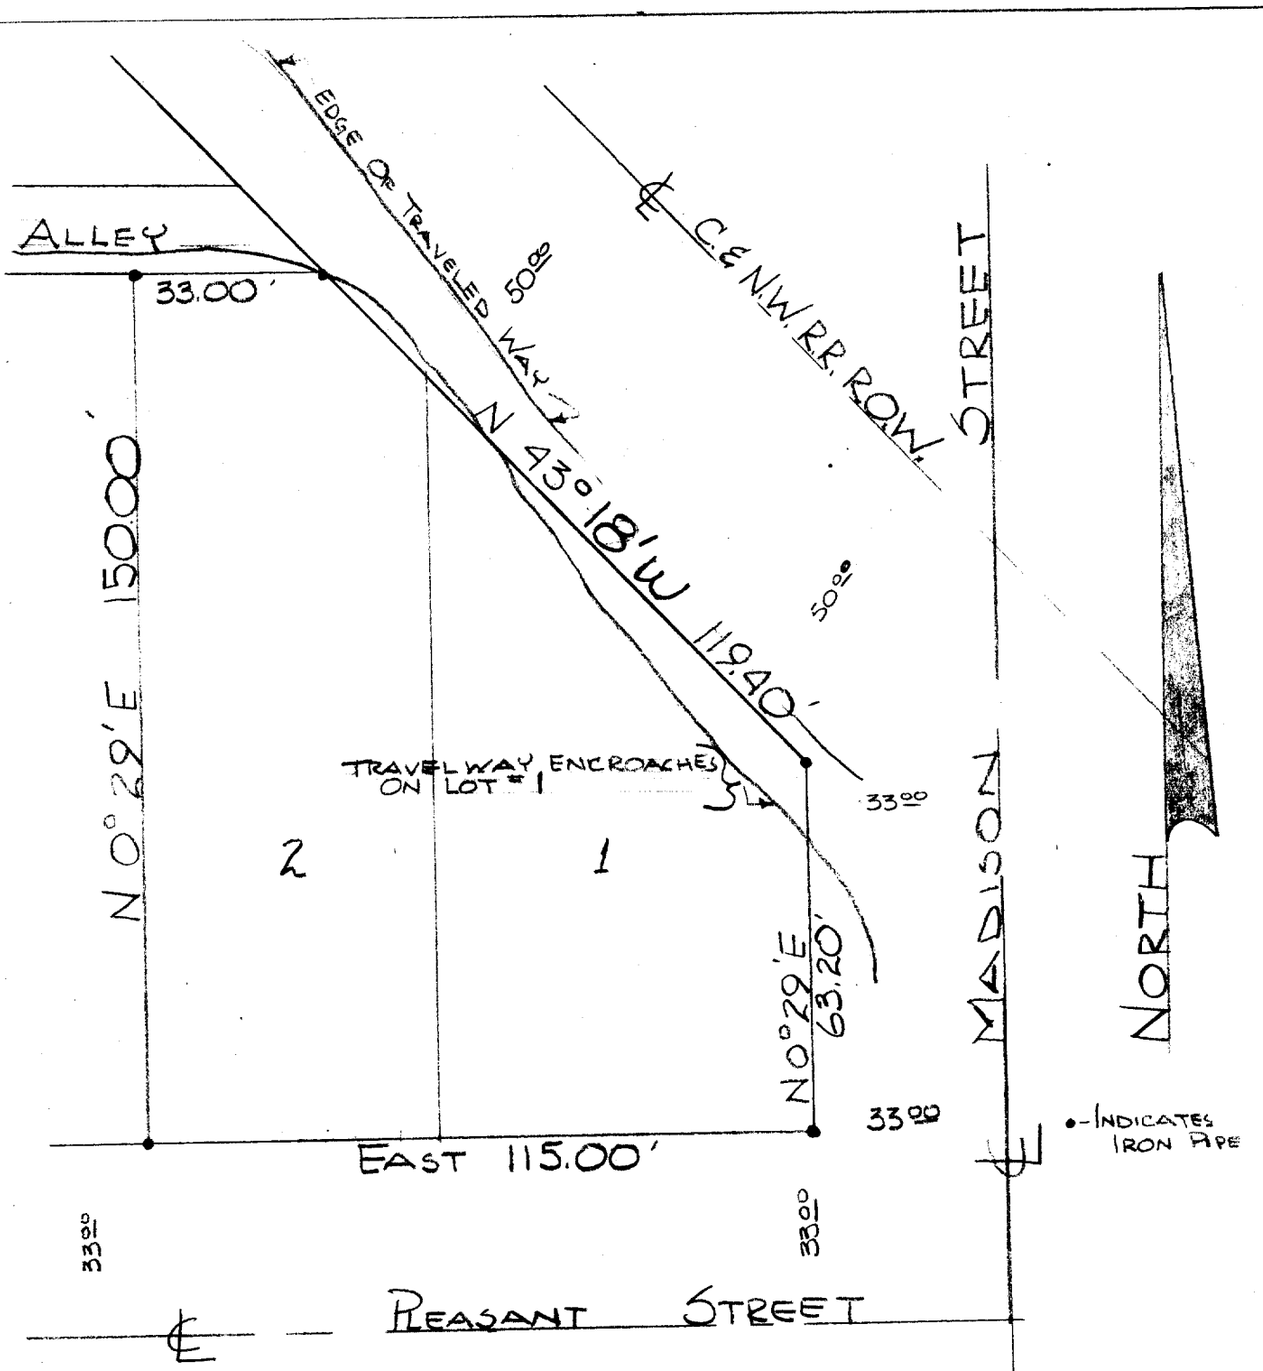


DESCRIPTION: Lots 1 & 2 of [redacted] subdivision in the City of Lake Geneva, Walworth County, Wisconsin.

CERTIFICATE: I, James F. [redacted], surveyor do hereby certify that I have surveyed the [redacted] on this [redacted] day of July, 1961.

James F. [redacted]

WISCONSIN
JAMES F.
[redacted]
MILWAUKEE, WIS.
LAND SURVEYOR

7-38

CL-1

7-38