
#775-67

WISCONSIN
JAMES F.
BIAGI
MILWAUKEE,
WIS.
LAND SURVEYOR

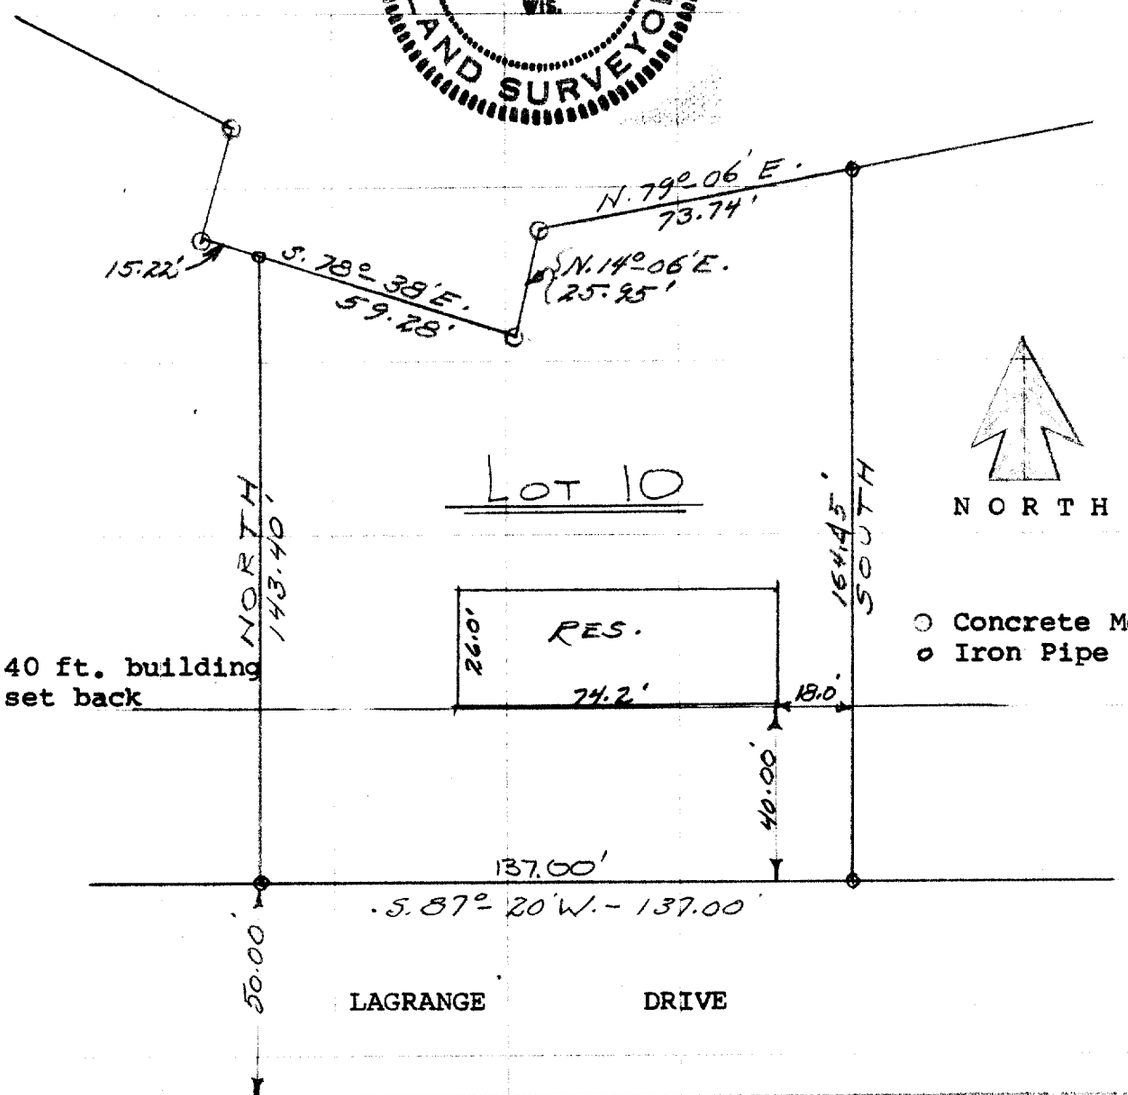

DESCRIPTION: Lot 10 of Lake Geneva East Shore Estates a subdivision of a portion of the City of Lake Geneva, Walworth County, Wisconsin.

CERTIFICATE: I, hereby certify that i have surveyed the above mentioned property and that the hereon portrayed is an accurate survey and a true representation thereof and correctly shows the exterior boundary lines and the location of the buildings and other improvements thereof.

James F. Biagi RLS 272
Elkhorn, Wisconsin

Dated: May 22nd 1967.

LE-10

7-40B