8 8/8/21

Survey of E½
Owner Ernest
Also set stakes
Also " "
building
Also took elevation
Building to 72 ft. long
Request to set level
end of cem walk.

73.65	3.61	77.26	Hgd. Main + War
	7.37	69.89	N.E. Cor. Leichty Walk
	7.77	69.27	N.W. Cor. "
	5.99	71.27	stakes E.
	4.99	72.27	" E'

level was

Decided to set Bldg at E'. or 72.27'
Building 11 lot lines,
2" iron stakes at 4 corners.
Measured West from N.E. + S.E. cor. stakes (set by Wm Child) 3rd St. Block 24. 620' for N.E. + S.E. corners Leichty lot. Measured west 90' for N.W. + S.W. Cors.
Measured H. O. Seymour's the has more than 90'
1, 2, 3, 4, 5, 6, 7, 8 are building line stakes.
Lot overruns N. & S.

Blk 23

Lot 8 and Lot 9. Block 23.
Leichty, per request of R. Soutar along E + W. lines of lot 15' apart for front + rear lines of
Toons for level of building and 29'10" N. + S.
Stakes 2' above inner cor. W.

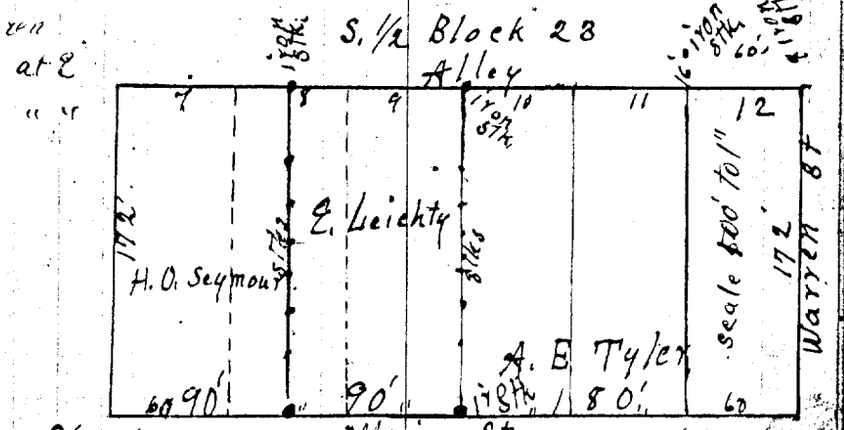

8/20/21 Stakes set all around bldg. and set at 72.27' or 1' above O. O. supposed unchanged

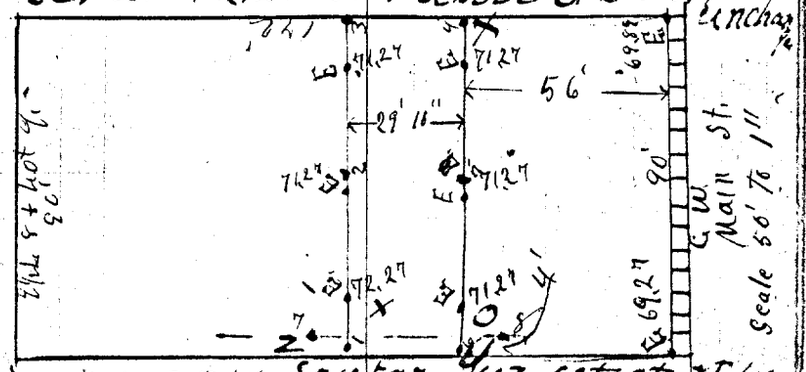

line X y. set by Soutar 42 set at 71.55 by Transit.

OP-220

7-434-lk