
46-16

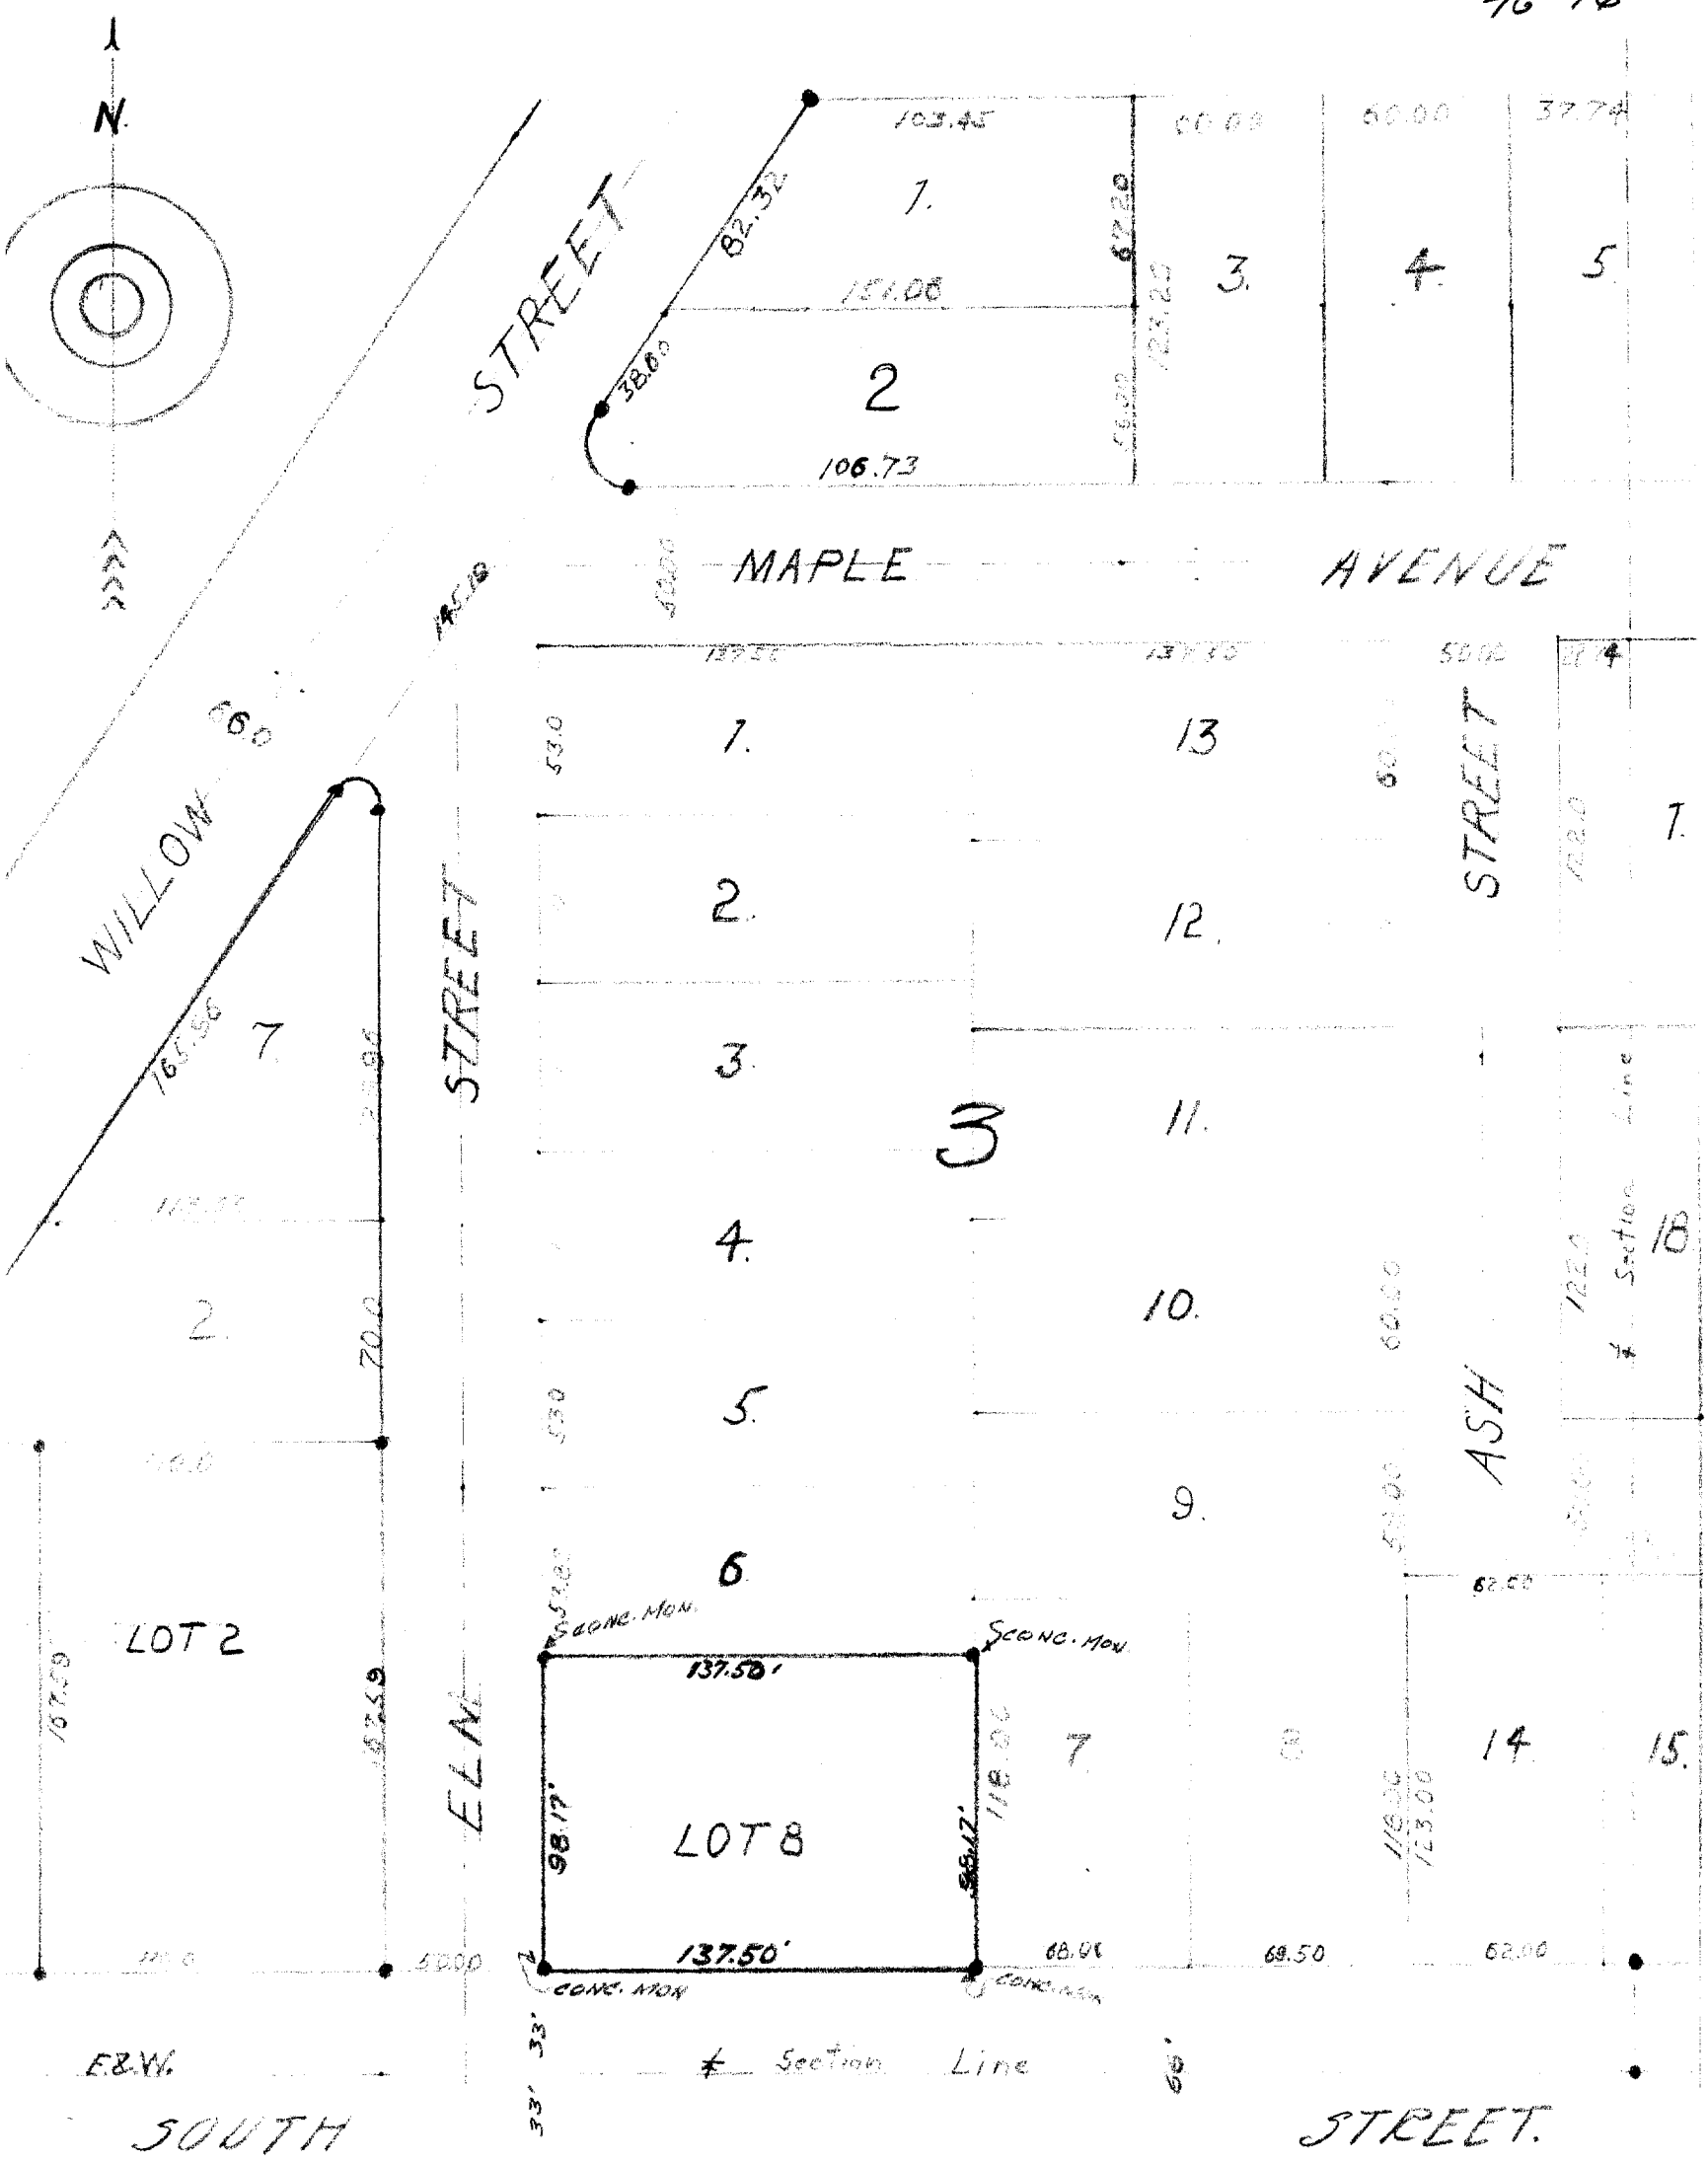

DRAWN BY JAMES F. BIAGI. 12/27/46.

DESCRIPTION::

Lot 8, Block 3; Lake Geneva Estates Subdivision of a portion of the City of Lake Geneva, Walworth County, Wisconsin.

CERTIFICATE:

I, Joseph M. Biagi; do hereby certify that I, have on this the 26th day of December 1946, surveyed the above described property according to the official records on file in the office of the Recorder of Deeds in and for Walworth County, Wisconsin, and find that the measurements and bearings of the boundary lines of said property, as taken at the site on this day, substantially agree with those upon the plat hereon portrayed and that no encroachments exist.

SIGNED AND SEALED THIS 30TH DAY OF DECEMBER 1946.

Joseph M. Biagi.
Professional Engineer.
Elkhorn Wisconsin.

ZLP 4

7-43B