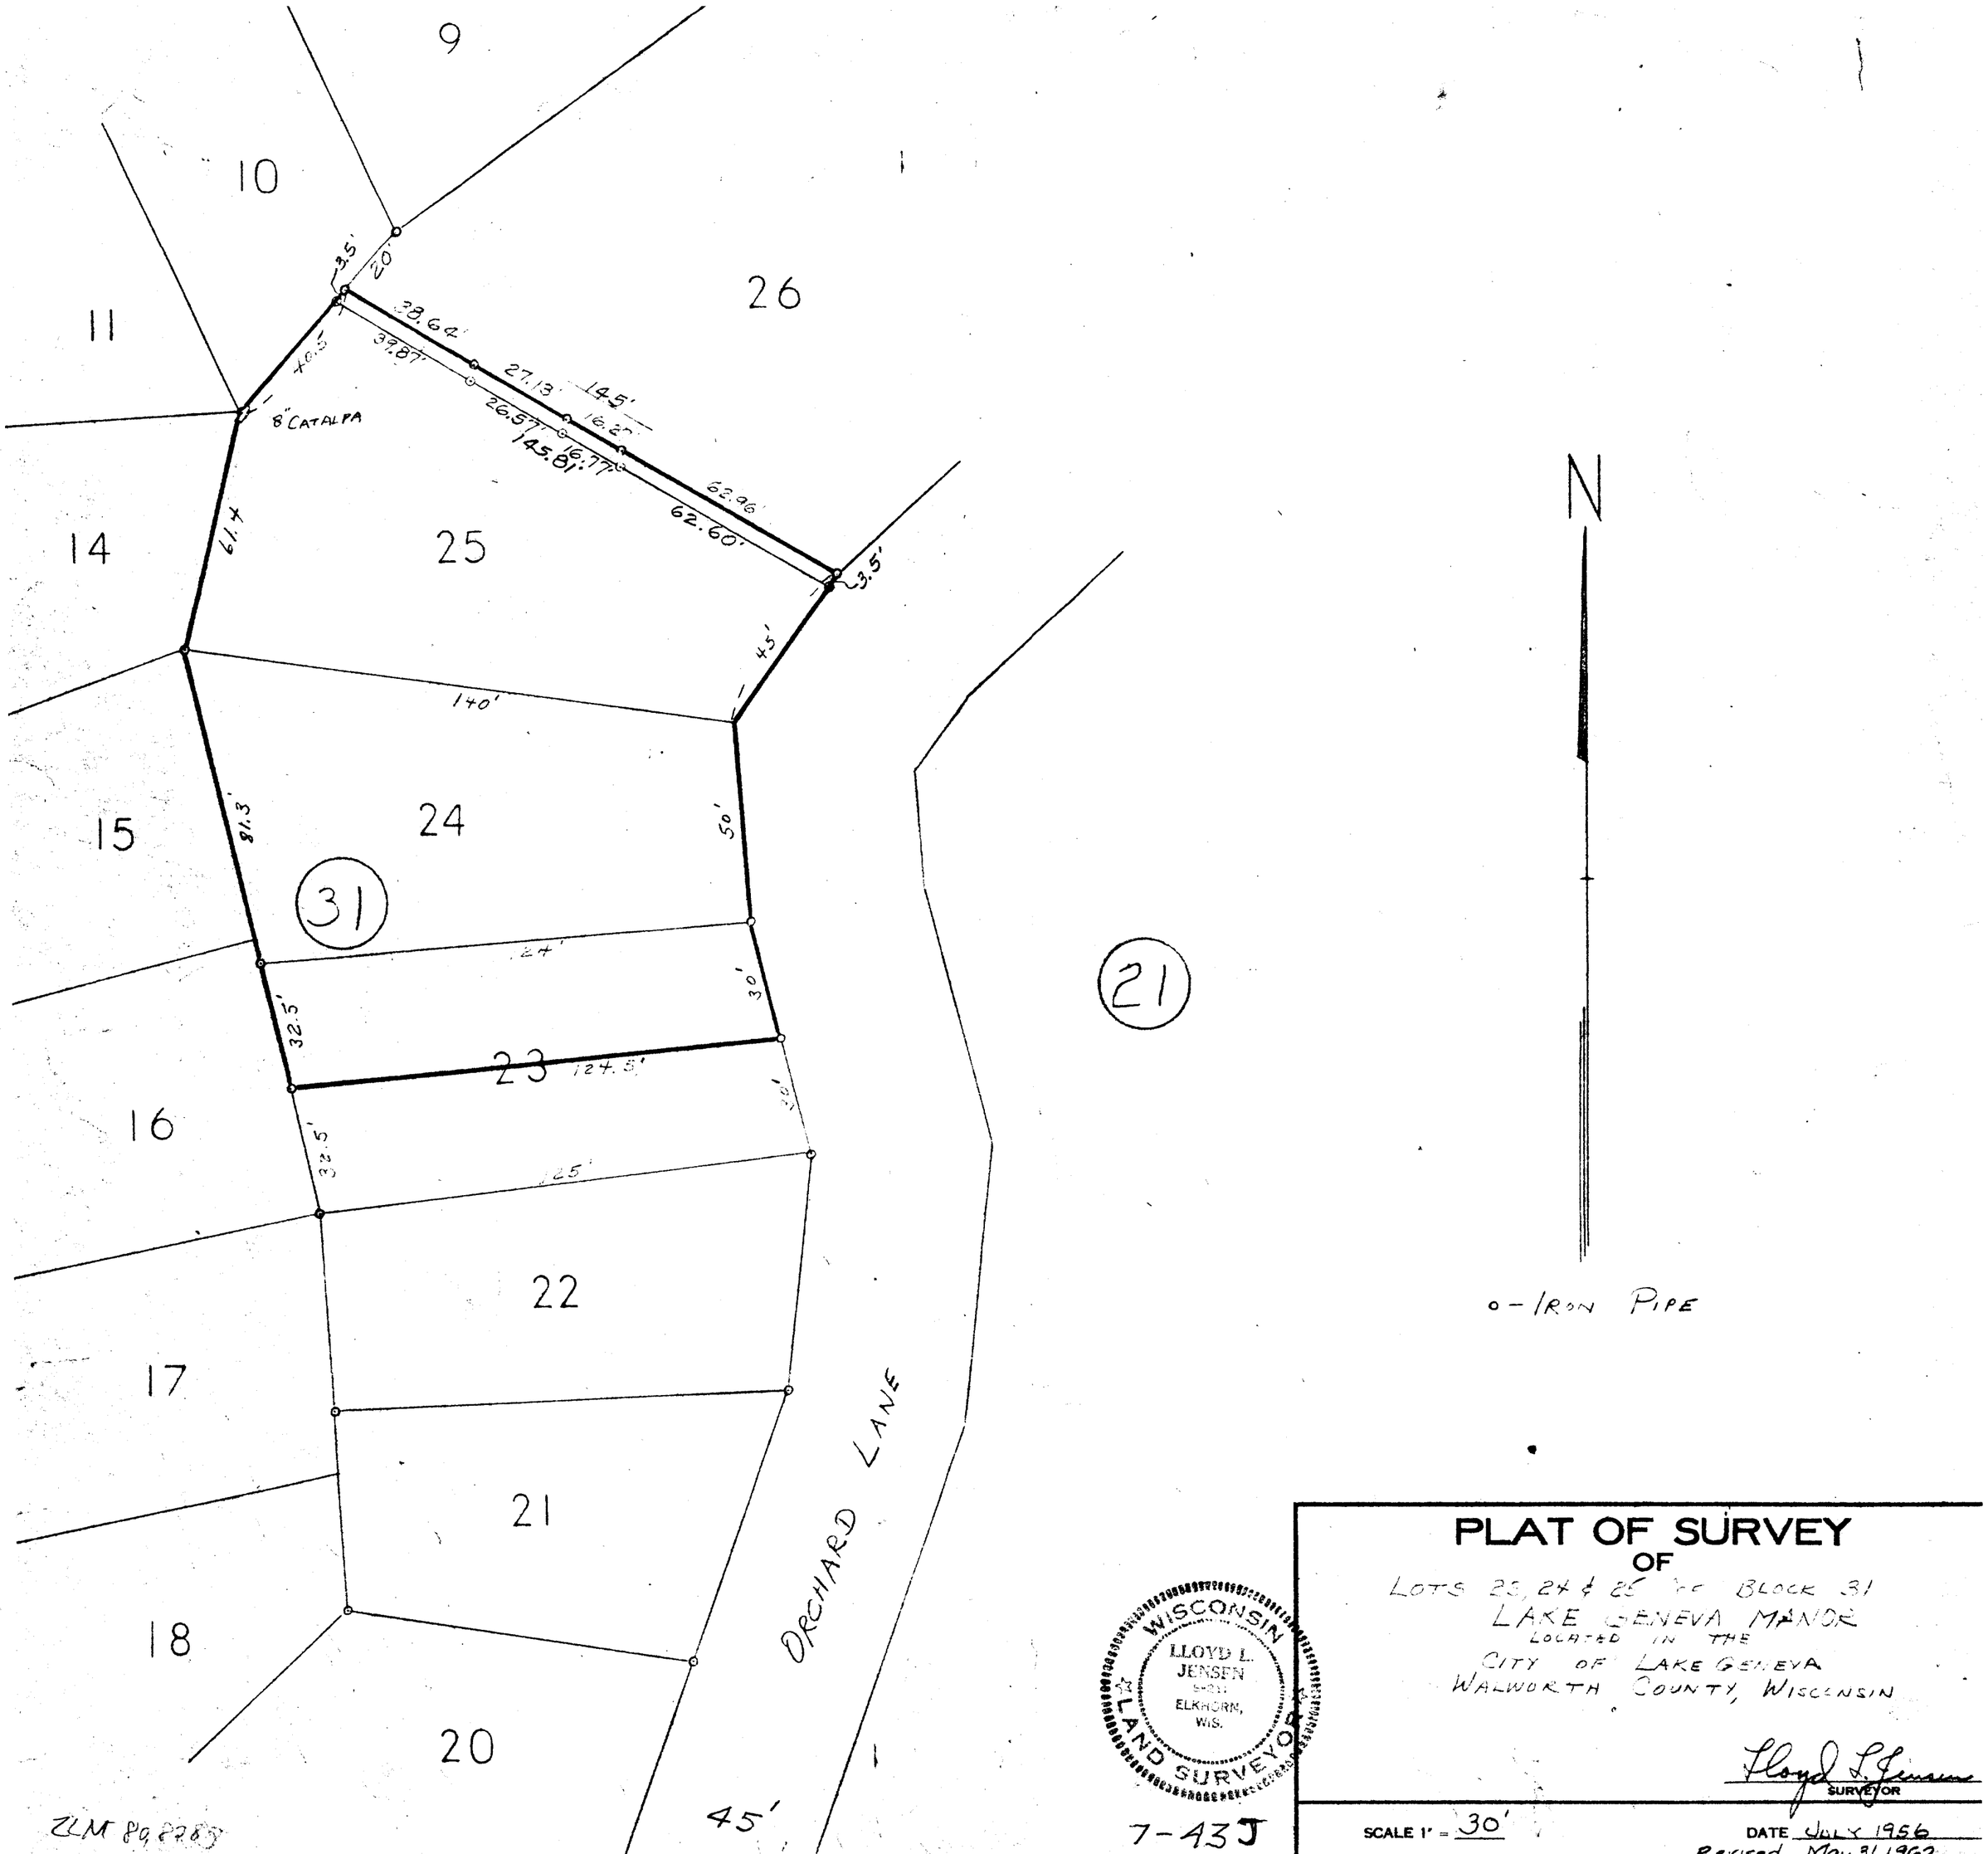

PLAT OF SURVEY

OF

LOTS 23, 24 & 25 OF BLOCK 31
LAKE GENEVA MANOR
LOCATED IN THE
CITY OF LAKE GENEVA
WALWORTH COUNTY, WISCONSIN

Lloyd L. Jensen
SURVEYOR

SCALE 1" = 30'

DATE JULY 1956
Revised May 31 1962

ZLM 89 228