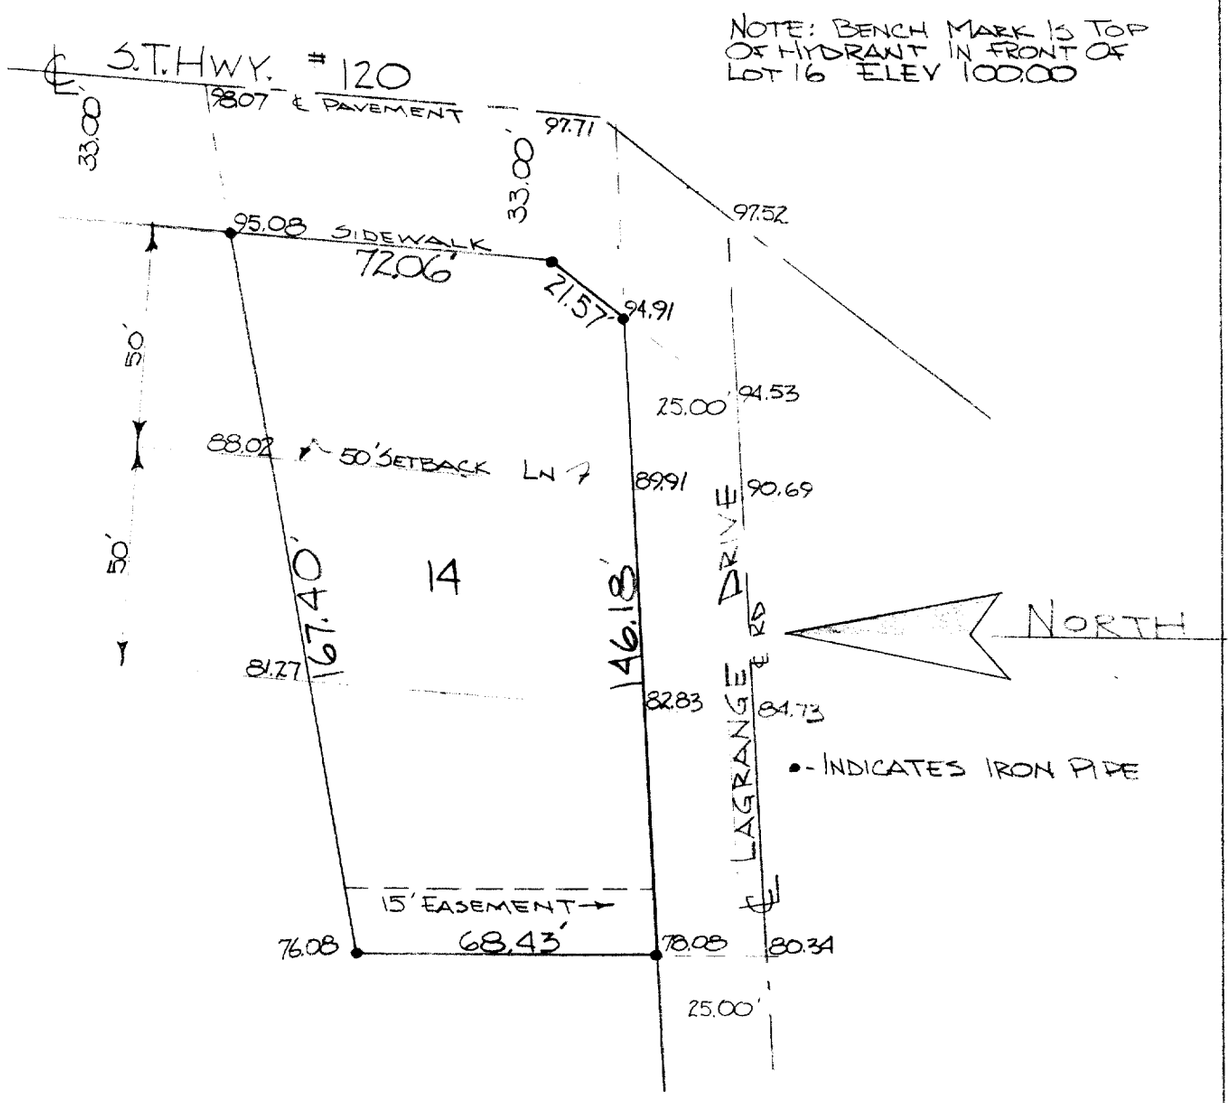


DESCRIPTION:

Lot 14, Lake Geneva East Shore Estates Subdivision of a portion of the City of Lake Geneva, Walworth County, Wisconsin.

CERTIFICATE:

I, hereby certify that I have on this the 28th day of March 1962. surveyed the above described property.

Signed and sealed on this the 29th day of March 1962.

James F. Biagi

James F. Biagi R.L.S. 272
Elkhorn, Wisconsin.

7-448