
o-INDICATES IRON PIPE

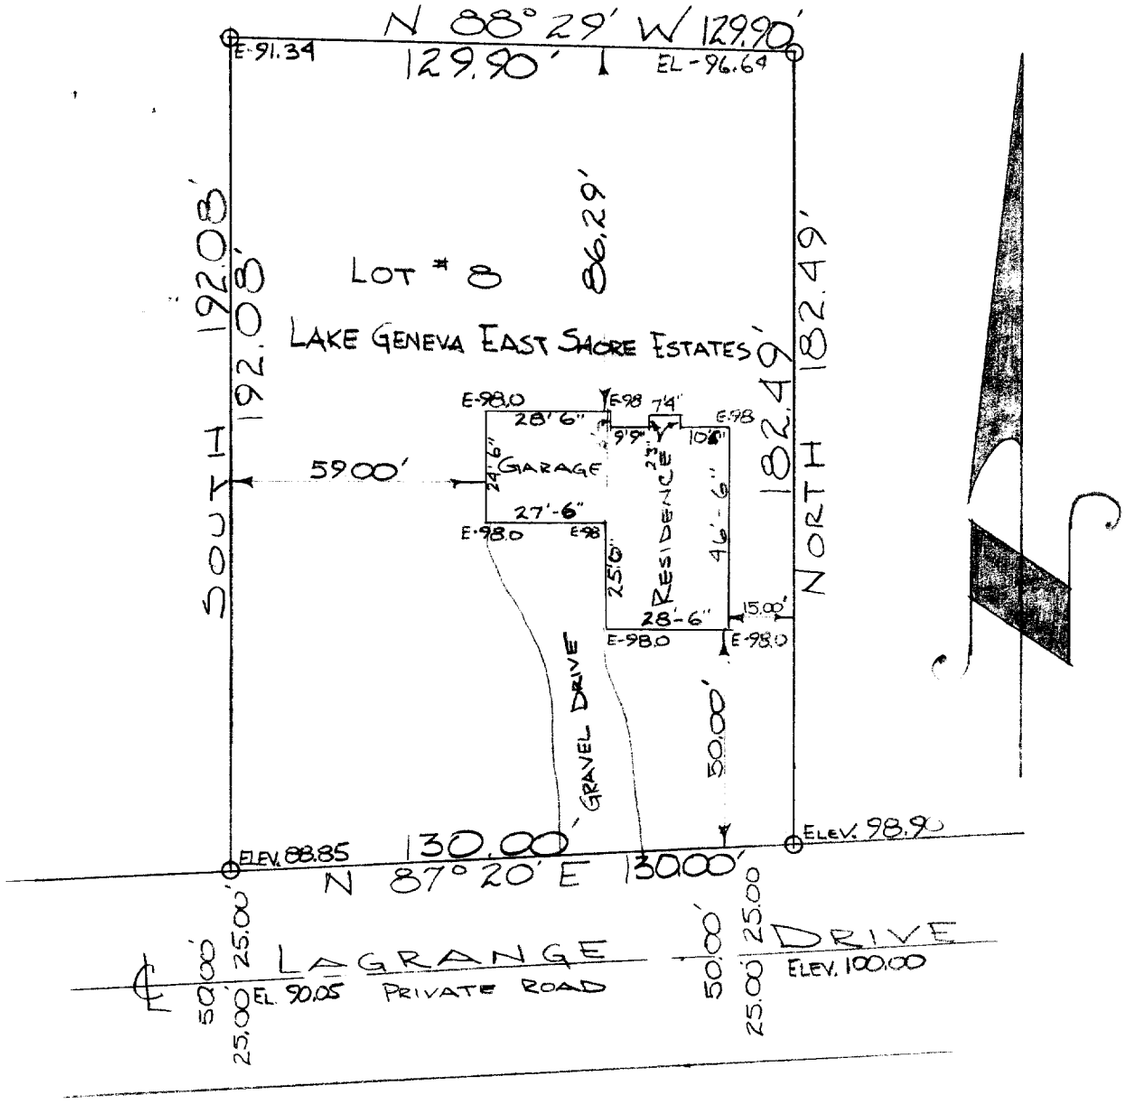

DESCRIPTION: Lot #8 of Lake Geneva East Shore Estates Subdivision, in the City of Lake Geneva, Walworth County, Wisconsin.

CERTIFICATE: I, James F. Biagi, surveyor, do hereby certify that I have surveyed the property hereon described and that the location of all the improvements are as shown on the drawing above.

June 20, 1968

James F. Biagi

WISCONSIN
JAMES F. BIAGI
MILWAUKEE, WIS.
LAND SURVEYOR

Z-C 8

7-46B