HAROLD H. KOLB
LAKE GENEVA, WIS. 53147

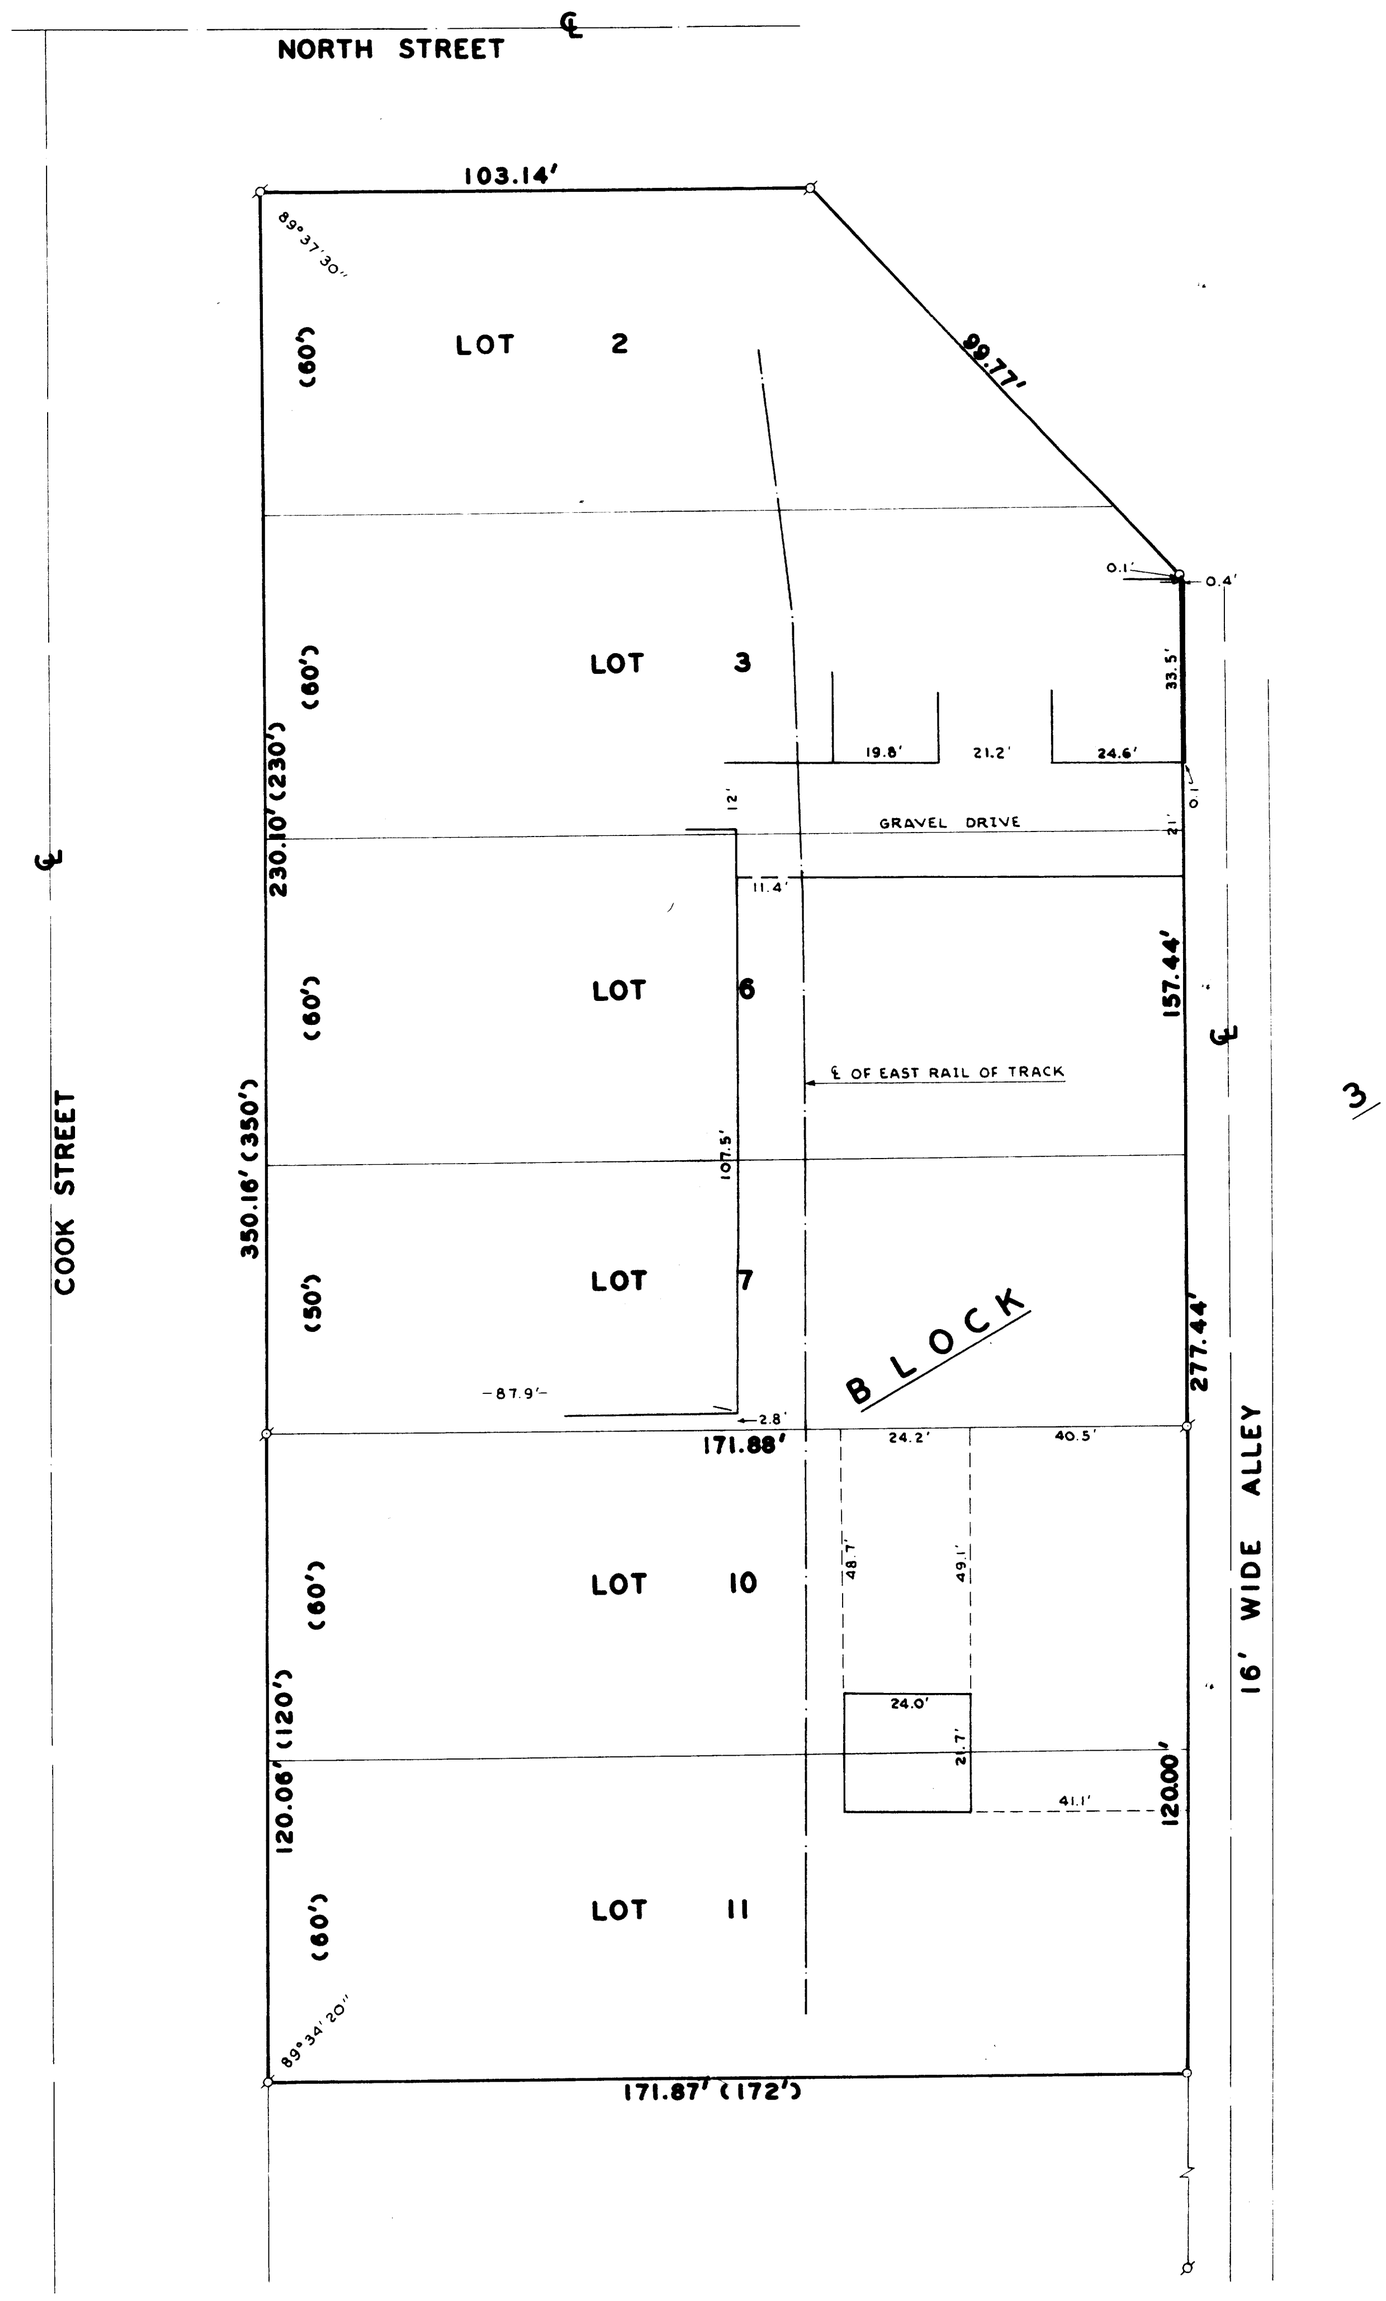

3/

N

SCALE: 1" = 20'

LEGEND

Ø — Iron Pipe Found
O — Iron Pipe Placed
() — Platted As

7-476