FARRIS, HANSEN & ASSOCIATES, INC.

ENGINEERING – ARCHITECTURE – SURVEYING
7 RIDGWAY COURT – P.O. BOX 437 – ELKHORN, WISCONSIN 53121
PHONE: (262) 723-2098 FAX: (262) 723-5886

GRID NORTH
WISCONSIN STATE PLANE COORDINATE SYSTEM SOUTH ZONE

PLAT OF SURVEY – AS-BUILT

UNIT 20 OF SUMMERHAVEN OF LAKE GENEVA II CONDOMINIUM
LOCATED IN PART OF THE NE 1/4 OF THE NE 1/4
OF SECTION 1, TOWN 1 NORTH, RANGE 17 EAST,
CITY OF LAKE GENEVA, WALWORTH COUNTY, WISCONSIN

– WORK ORDERED BY –
BASSO BUILDERS, INC.
405 SKYLINE DRIVE
LAKE GENEVA, WI 53147

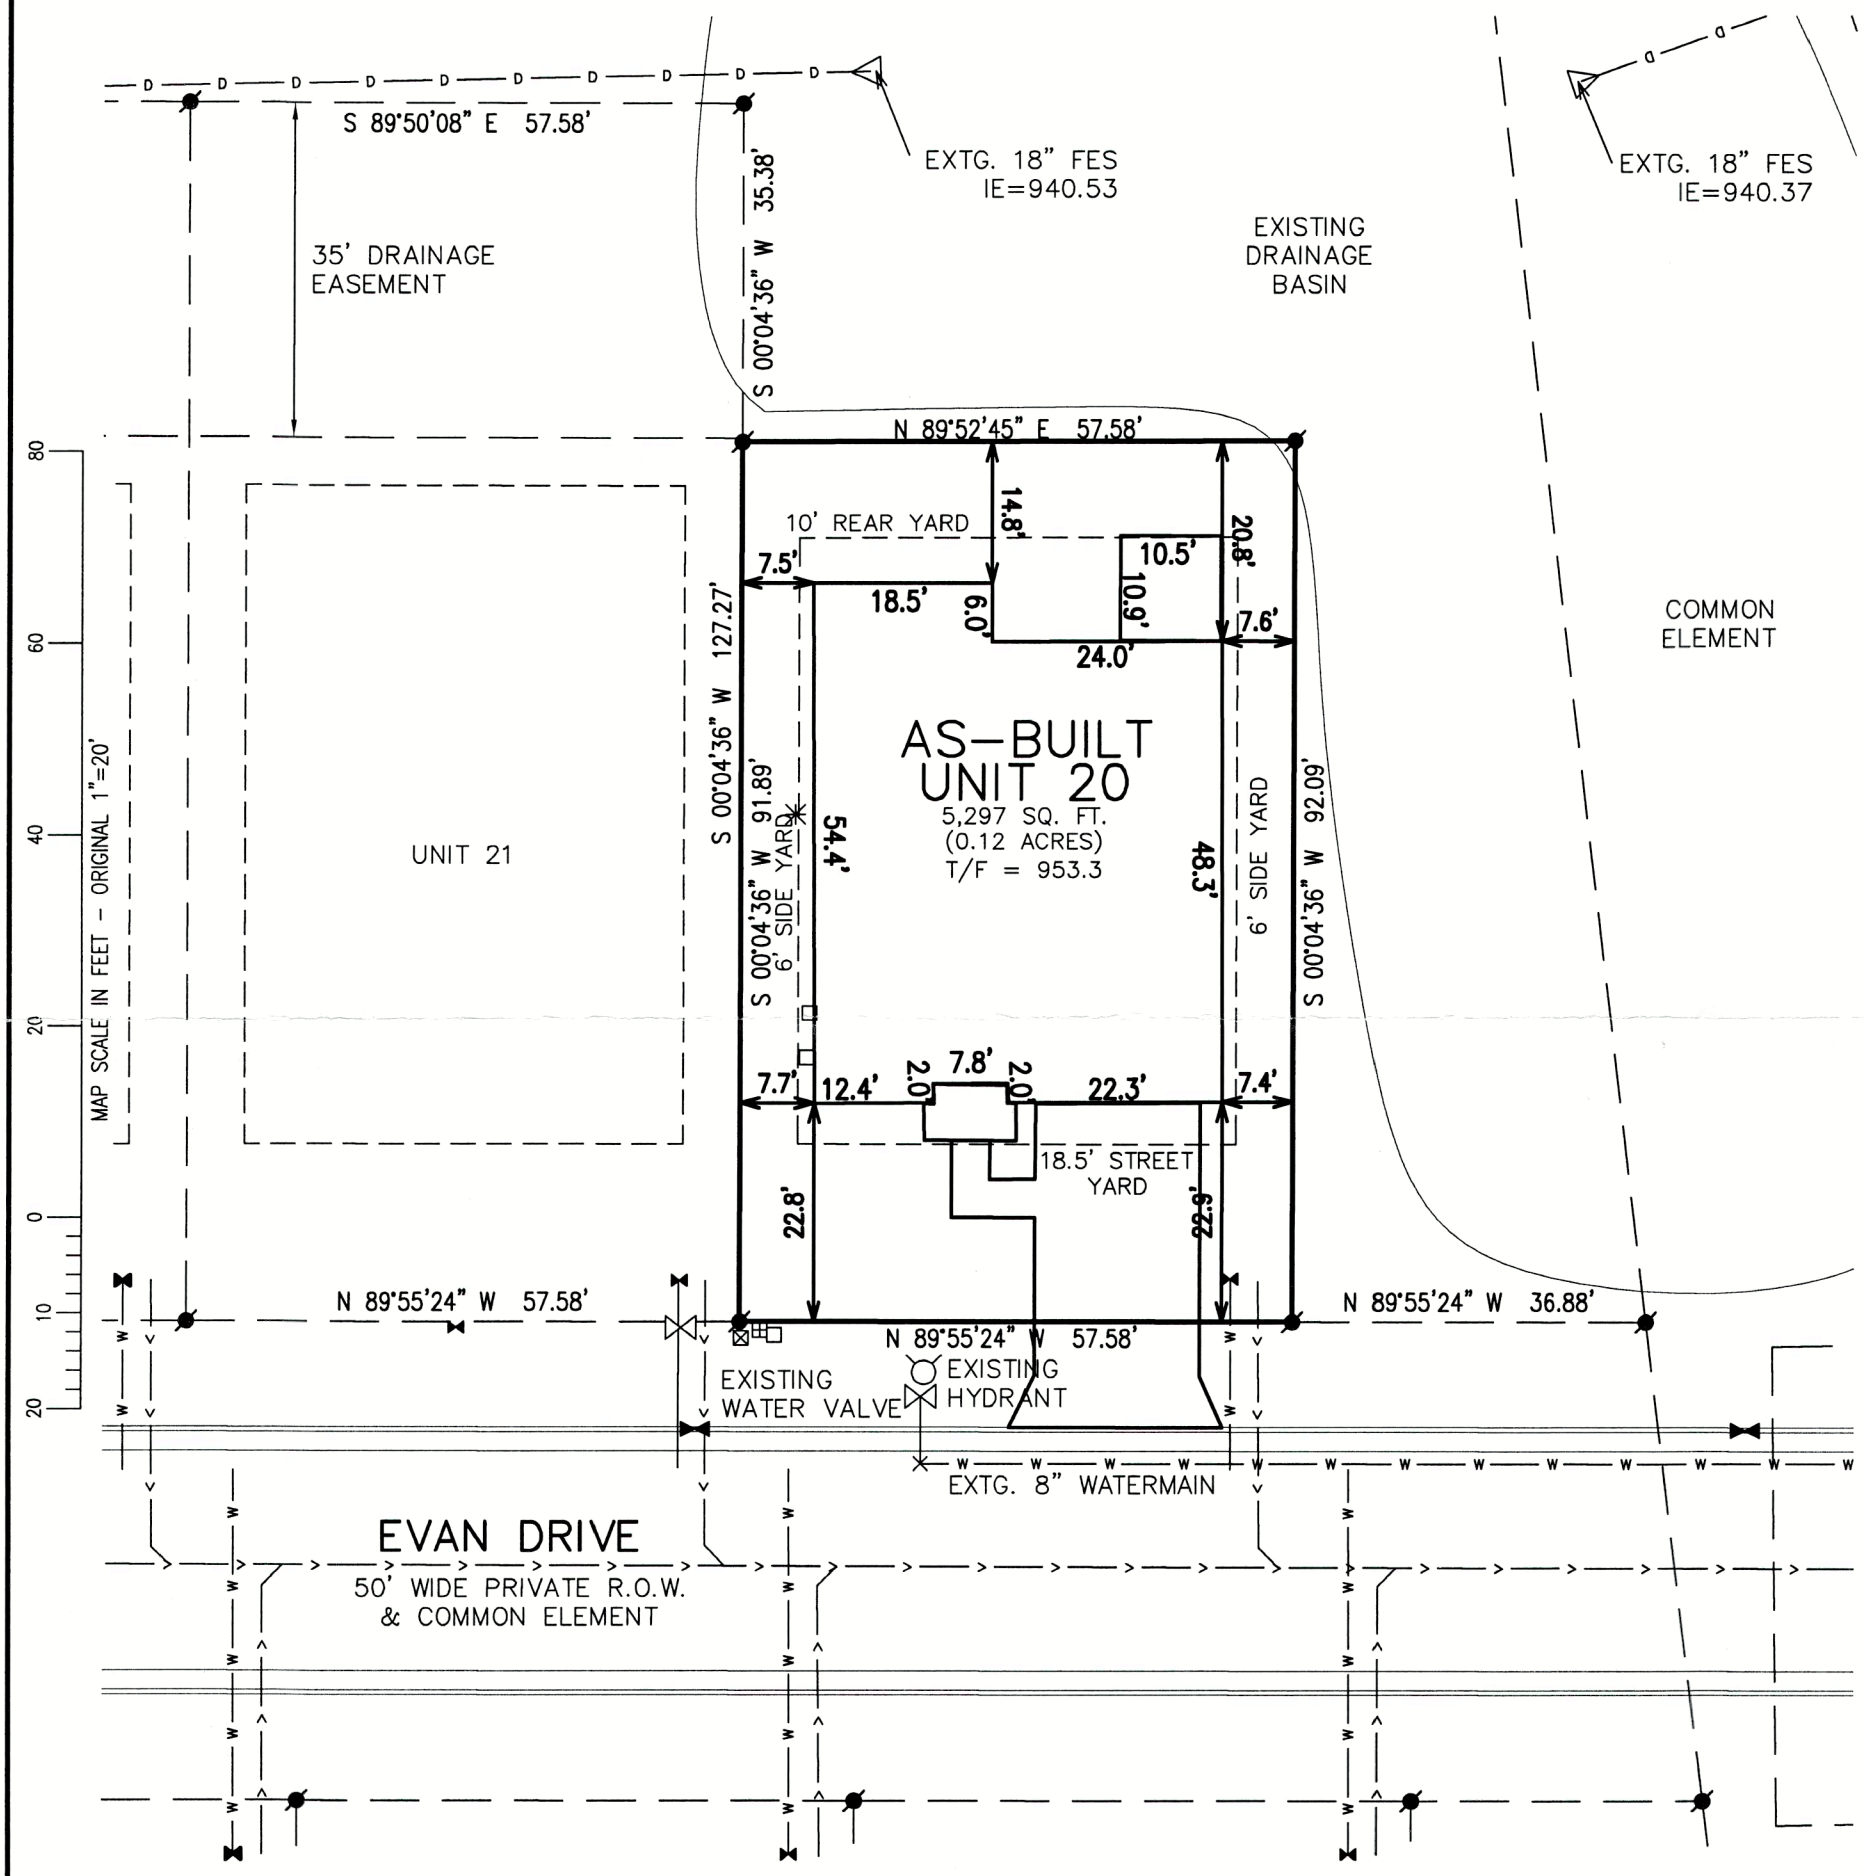

NOTE: COPIES OF THIS MAP TO WHICH THE FOLLOWING CERTIFICATE WILL APPLY SHOW THE SURVEYOR'S ORIGINAL SEAL AND SIGNATURE IN RED INK. COPIES BY ANY OTHER MEANS MAY HAVE ALTERATIONS WHICH DO NOT REPRESENT THE SURVEYOR'S WORK PRODUCT.

I HEREBY CERTIFY THAT THE ABOVE DESCRIBED PROPERTY HAS BEEN SURVEYED UNDER MY DIRECTION AND THAT THE ABOVE MAP IS A TRUE REPRESENTATION THEREOF AND SHOWS THE SIZE AND LOCATION OF THE PROPERTY AND ITS EXTERIOR BOUNDARIES. THIS SURVEY IS MADE FOR THE USE OF THE PRESENT OWNERS OF THE PROPERTY, AND ALSO THOSE WHO PURCHASE, MORTGAGE, OR GUARANTEE THE TITLE THERETO WITHIN ONE YEAR FROM THE DATE HEREOF. FIELDWORK COMPLETED IN 2020.

DATED: 08/26/2025

CHRISTOPHER A. HODGES P.L.S. 2760

WISCONSIN
CHRISTOPHER A. HODGES
S-2760
ELKHORN, WIS.
LAND SURVEYOR

LEGEND

● = REBAR STAKE FOUND

{XXX} = RECORDED AS

PROJECT: 8868.20
DATE: 9/19/2024
SHEET 1 OF 1

X:\Projects\8868\INDIV_LOTS\8868_20\ACAD\8868-20.dwg

ZSUM2-20 007-4771