
HAROLD H. KOLB

REGISTERED PROFESSIONAL LAND SURVEYOR
LAKE GENEVA, WISCONSIN

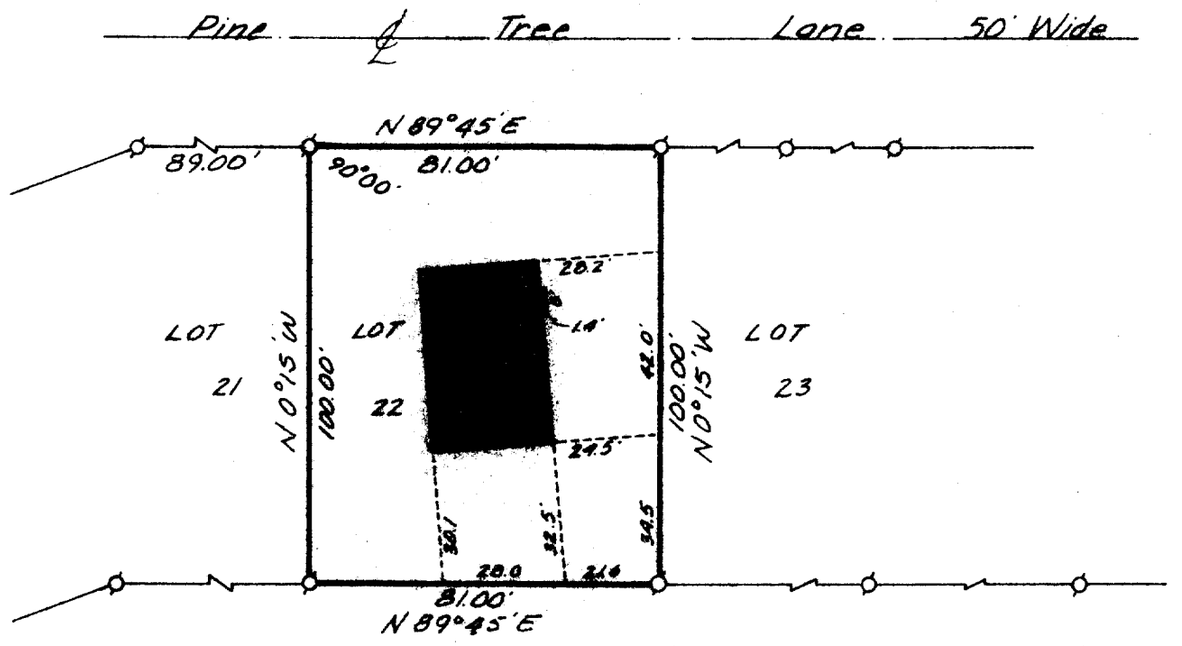

PLAT OF SURVEY OF

Lot 22, Syver Stad Subdivision, City of Lake Geneva, Walworth County, Wisconsin.

N

Scale: 1" = 40'

LEGEND

- ϕ — IRON PIPE FOUND
- O — IRON PIPE PLACED
- ● — CONCRETE MONUMENT
- x — SPIKE

WISCONSIN
HAROLD H. KOLB
S-187
LAKE GENEVA, WIS.
LAND SURVEYOR

I. HAROLD H. KOLB, DO HEREBY CERTIFY THAT I HAVE SURVEYED THE PROPERTY HEREON DESCRIBED ACCORDING TO THE OFFICIAL RECORDS, AND THAT THE PLAT HEREON IS A CORRECT REPRESENTATION OF THE LOT LINES.

Harold H. Kolb

HAROLD H. KOLB
WISCONSIN REGISTERED LAND SURVEYOR, S-187
DATE May 10, 1974

254-22

7-479

BRUNING 40-105 1M-6-71