
#72-63

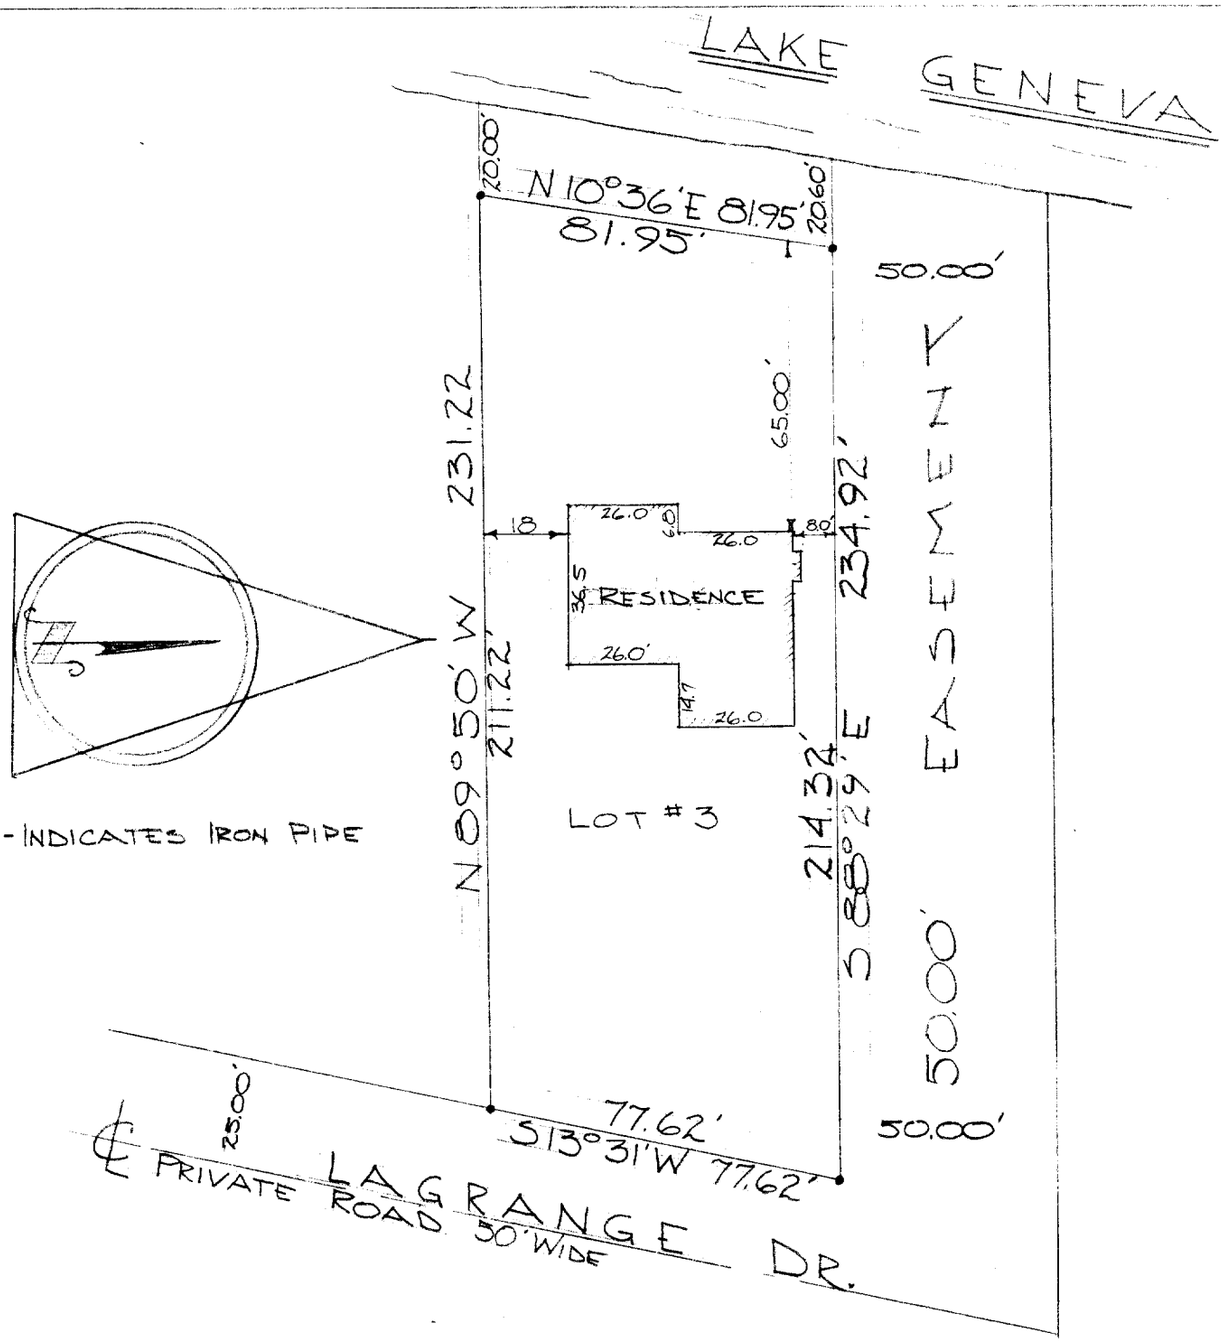

•- INDICATES IRON PIPE

DESCRIPTION: Lot 3 of Lake Geneva East Shore Estates Subdivision located in the City of Lake Geneva, Walworth County, Wisconsin.

CERTIFICATE: I, James F. Biagi, Surveyor, do hereby certify that I have surveyed the property hereon described, also that the location of the improvements are as shown.

August 28, 1963

James F. Biagi

James F. Biagi RLS 272

WISCONSIN JAMES F. BIAGI MILWAUKEE, WIS. LAND SURVEYOR

2LE3

7-47B