
60-44

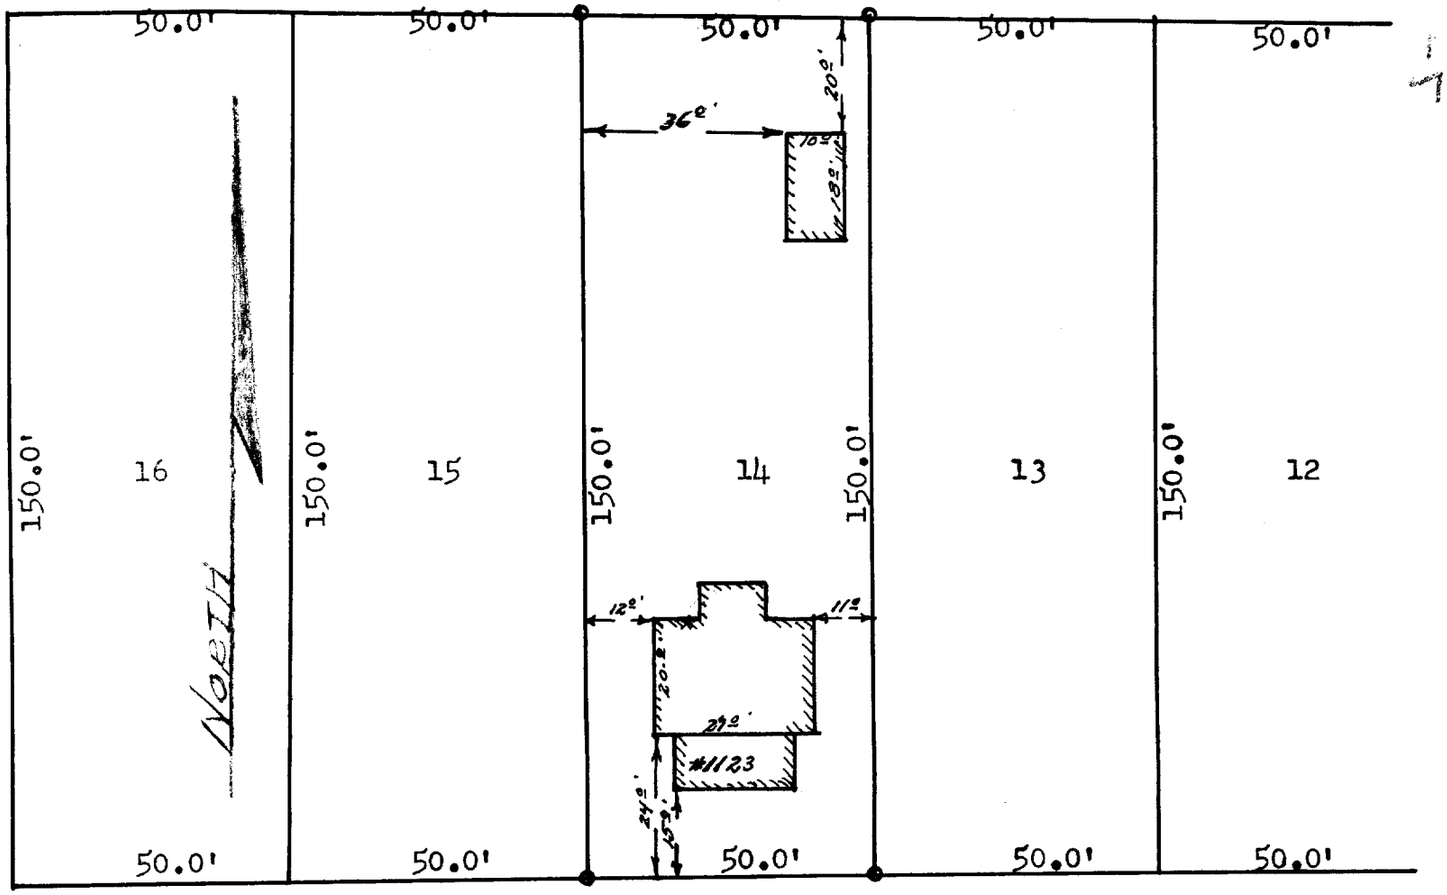

DESCRIPTION:

Lot 14, Columbian Subdivision of a portion of the City of Lake Geneva, Walworth County, Wisconsin.

CERTIFICATE:

I, James F. Biagi. Surveyor, do hereby certify that I have surveyed the property hereon described and that the location of the improvements are as shown on the above drawing.

SIGNED AND SEALED ON THIS THE 5TH DAY OF AUGUST 1960.

James F. Biagi

James F. Biagi. RLS (272)

7-4B