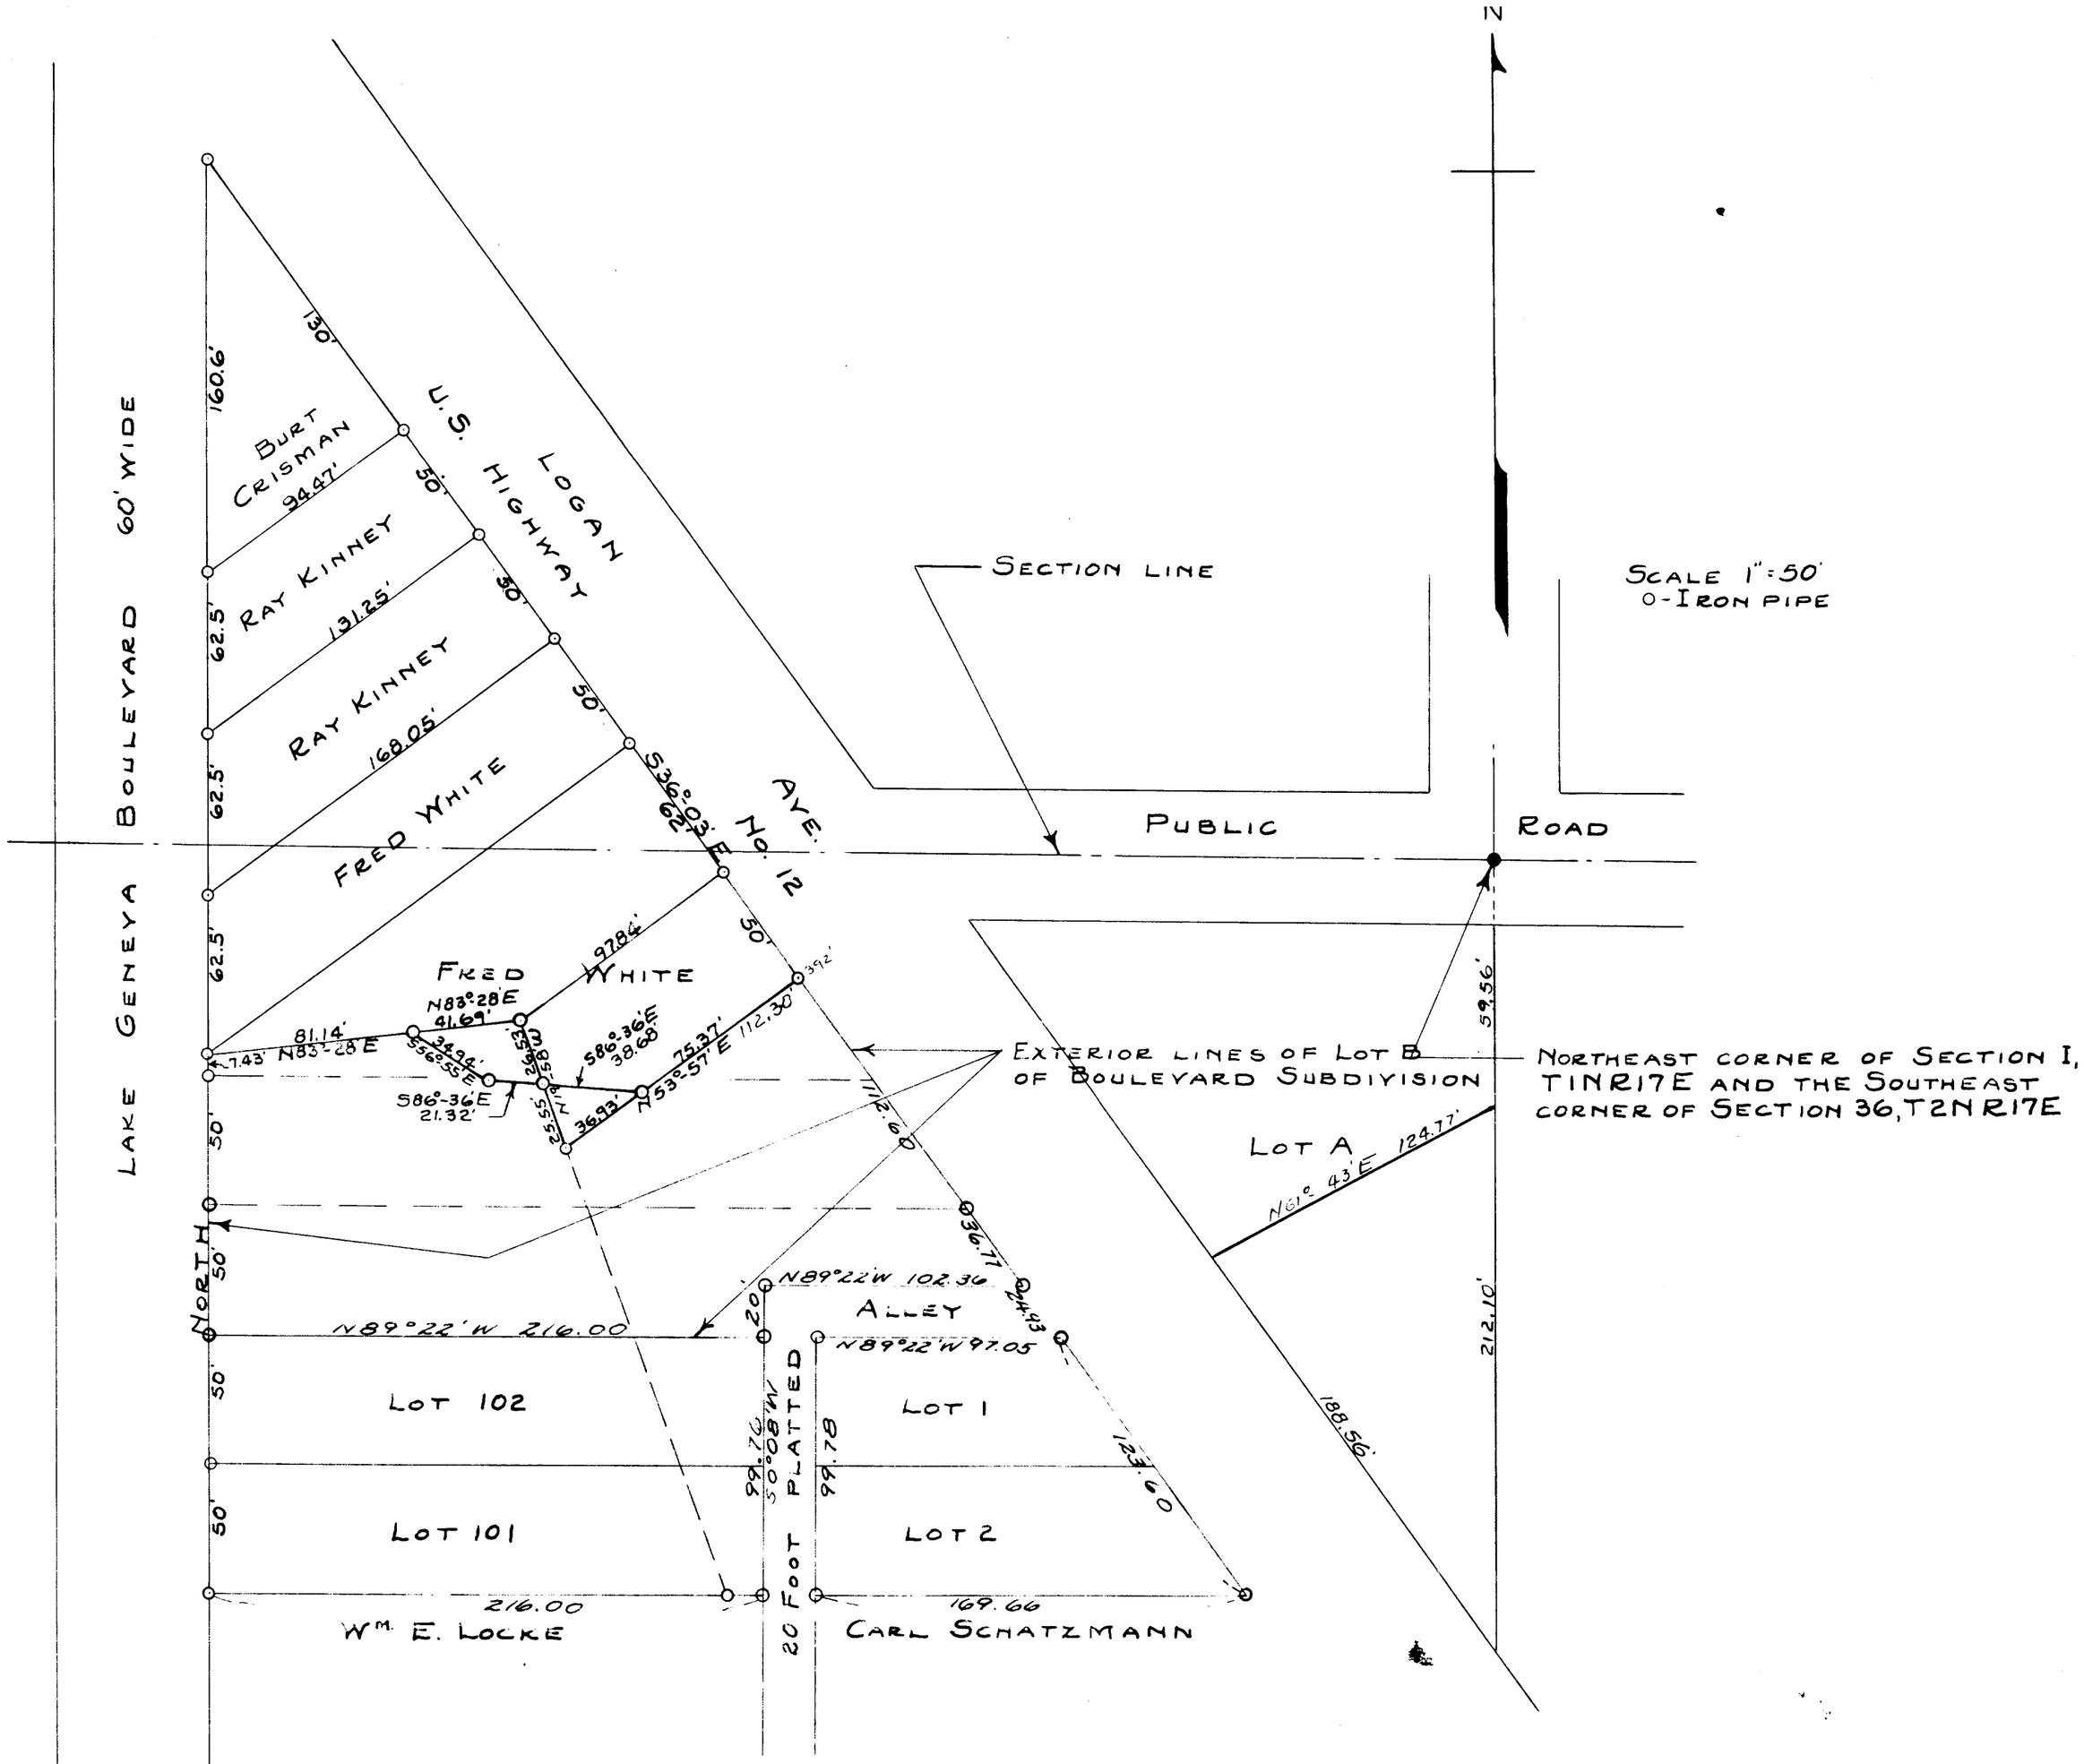

PLAT OF SURVEY OF PART OF LOT B OF BOULEVARD SUBDIVISION, WHICH SUBDIVISION IS LOCATED IN SECTION 1, T1N R17E AND SECTION 36, T2N R17E OF WALWORTH COUNTY WISCONSIN

MAY 1945

Floyd L. Jensen
COUNTY SURVEYOR

INFORMATION ON LAND TO BE BOUGHT BY E. HOST ADDED IN MAY, 1946

H. E. Johnson
-SURVEYOR-

PLAT REVISED DEC. 2, 1952

Floyd L. Jensen
FLOYD L. JENSEN

BL-5

7-4J