
57-13

PLAT OF SURVEY

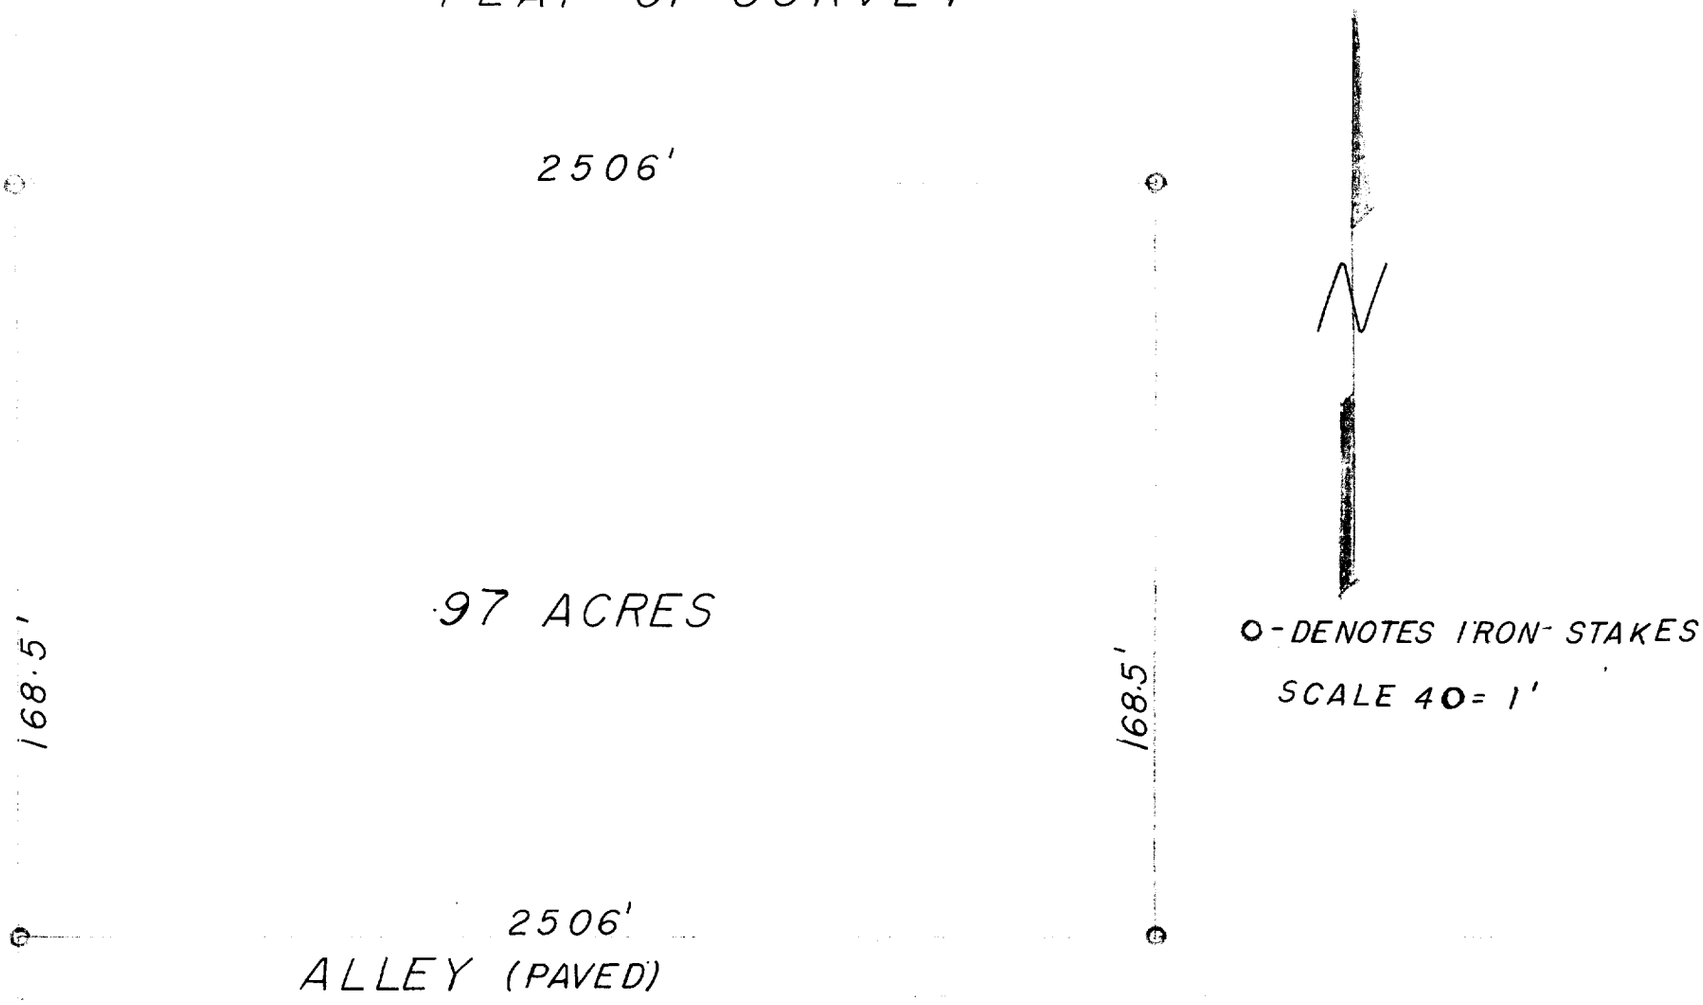

DESCRIPTION: The West ½ Of Lot 11, Columbian Second Subdivision of a portion of Lake Geneva Walworth County Wisconsin.

CERTIFICATE: I, hereby certify that I have on this the 12th day of July 1957, surveyed the above described property, and the plat here drawn is a correct portrayal of said survey and that no encraochments exist.
SIGNED AND SEALED ON THIS THE 15TH DAY OF JULY 1957.

Joseph M. Biagi. P.E.
Registered surveyor
Elkhorn Wisconsin.

7-52 B