
HAROLD H. KOLB

REGISTERED PROFESSIONAL LAND SURVEYOR

LAKE GENEVA, WISCONSIN

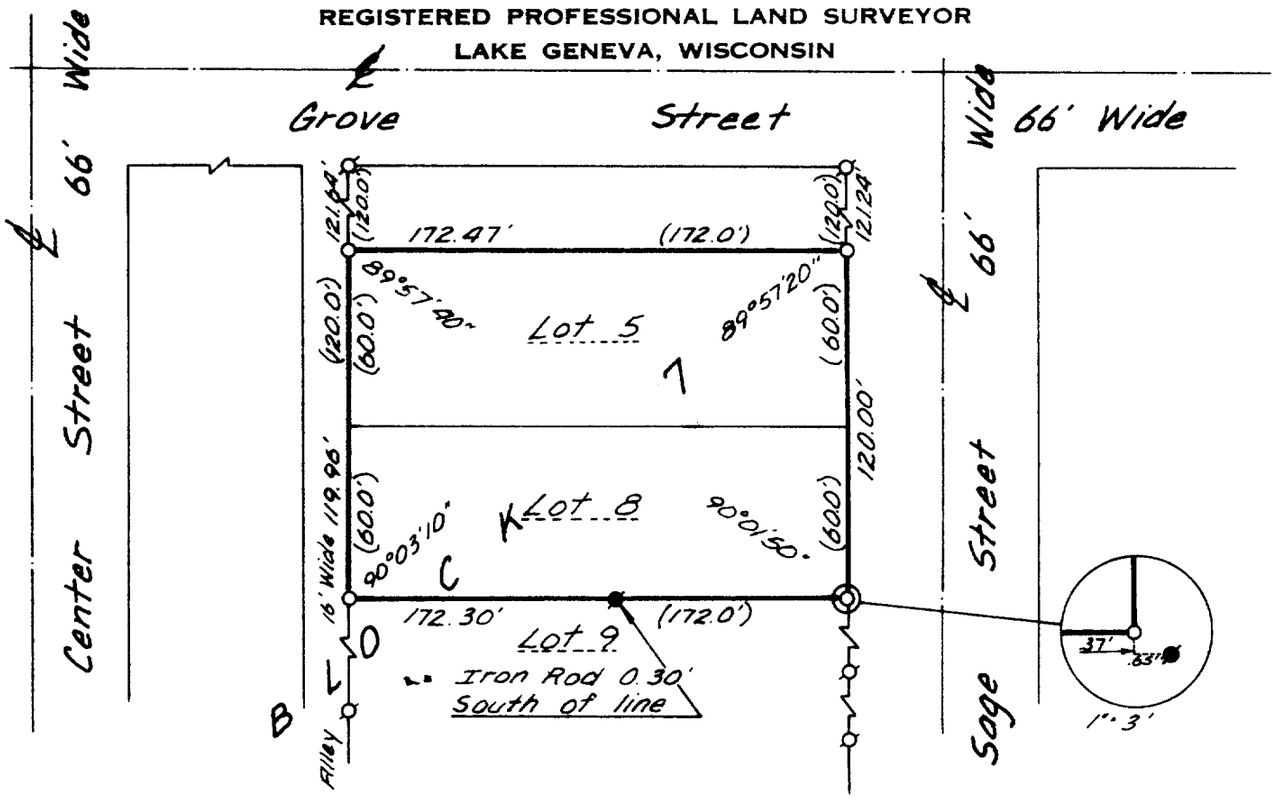

PLAT OF SURVEY OF

LOTS 5 AND 8, BLOCK 7, GENEVA LAKE CRAWFORD MANUFACTURING SUBDIVISION, CITY OF LAKE GENEVA, WALWORTH COUNTY, WISCONSIN.

OWNER: PHIL ROBERS

ACCURACY: DISTANCES: ± 0.01'
ANGLES: ± 05"
ERROR OF CLOSURE: LESS THAN ONE PART IN 3,000

N

Scale: 1" = 60'

LEGEND

- ϕ — IRON PIPE FOUND
- O — IRON PIPE PLACED
- ø — IRON ROD FOUND
- x — SPIKE



I. HAROLD H. KOLB, DO HEREBY CERTIFY THAT I HAVE SURVEYED THE PROPERTY HEREON DESCRIBED ACCORDING TO THE OFFICIAL RECORDS. AND THAT THE PLAT HEREON IS A CORRECT REPRESENTATION OF THE LOT LINES.

EUGENE A. BLOMQUIST FOR
HAROLD H. KOLB
WISCONSIN REGISTERED LAND SURVEYOR, S-187
DATE Jan 12, 1976

7-537-A