
KOLB LAND CONSULTING, INC.

LAND SURVEYING · SUBDIVIDING · LAND PLANNING

LAKE GENEVA, WISCONSIN 53147 WHITEWATER, WISCONSIN 53190

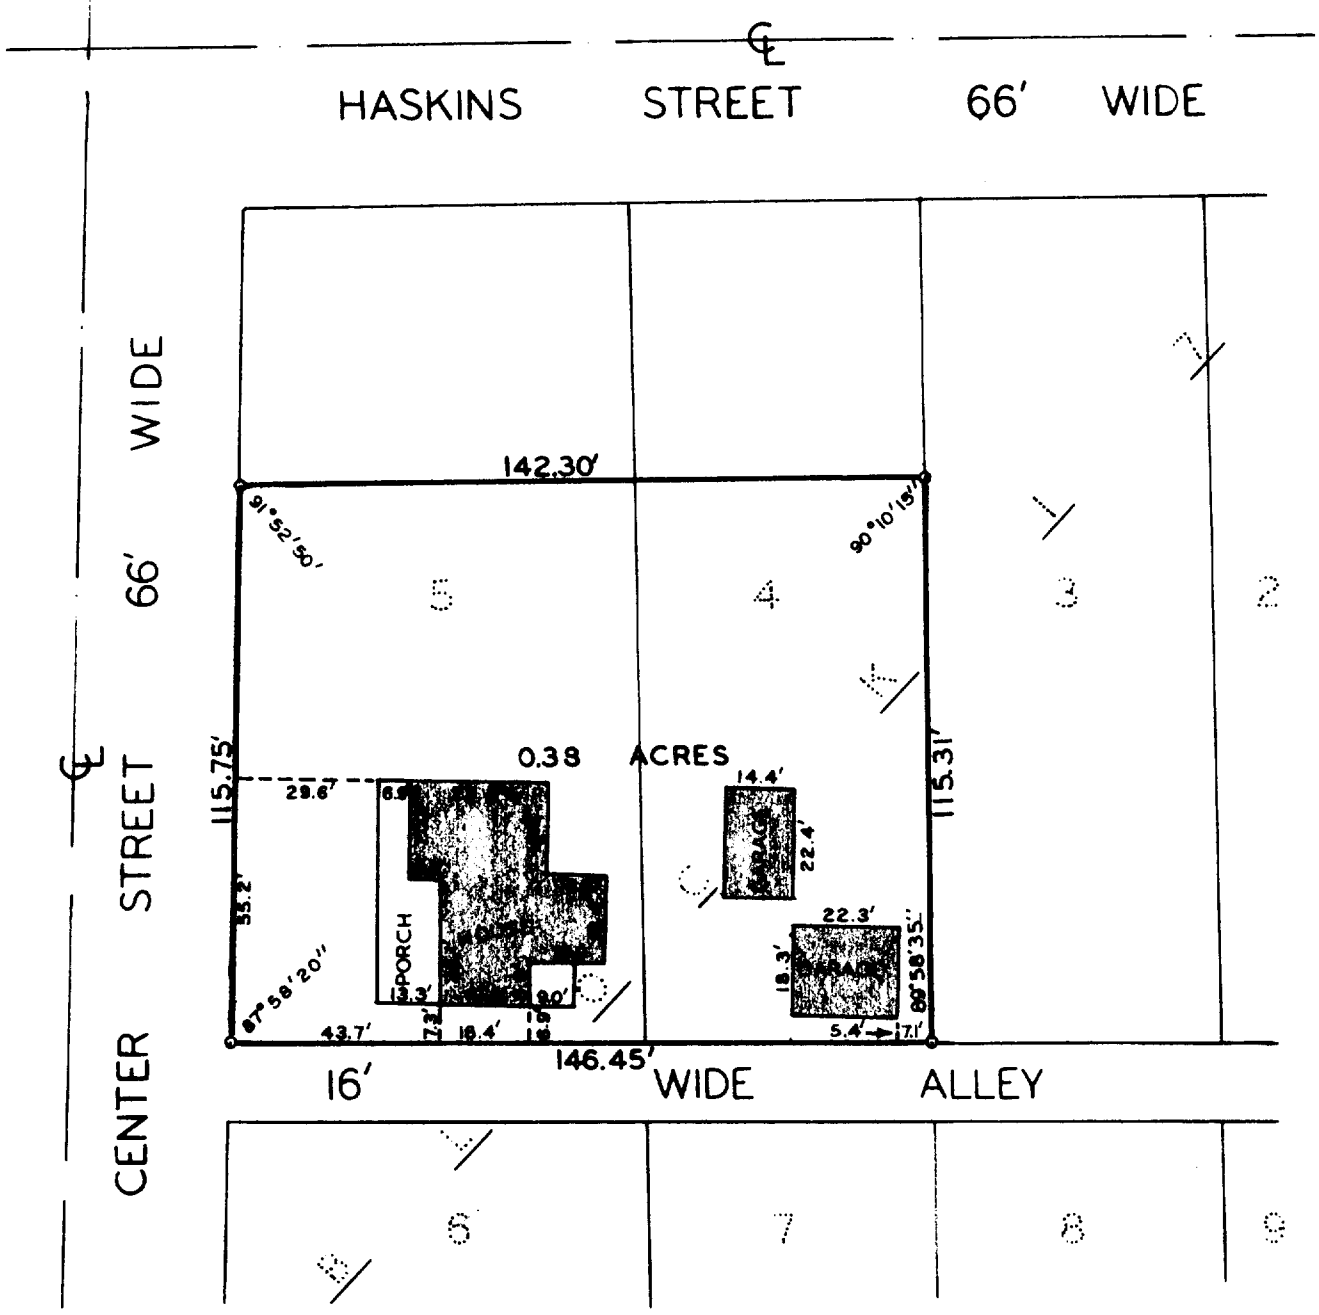

PLAT OF SURVEY OF


ORDERED BY: [illegible]
[illegible] CENTER STREET
LAKE GENEVA, WI. 53147

SCALE 1"=40'

LEGEND:
o-IRON PIPE PLACED

WISCONSIN
HAROLD H. KOLB
S-187
LAKE GENEVA, WIS.
LAND SURVEYOR

Harold H. Kolb

HAROLD H. KOLB
WISCONSIN REGISTERED LAND SURVEYOR, S-187

DATE April 20, 1979

26C-84B

7-537K