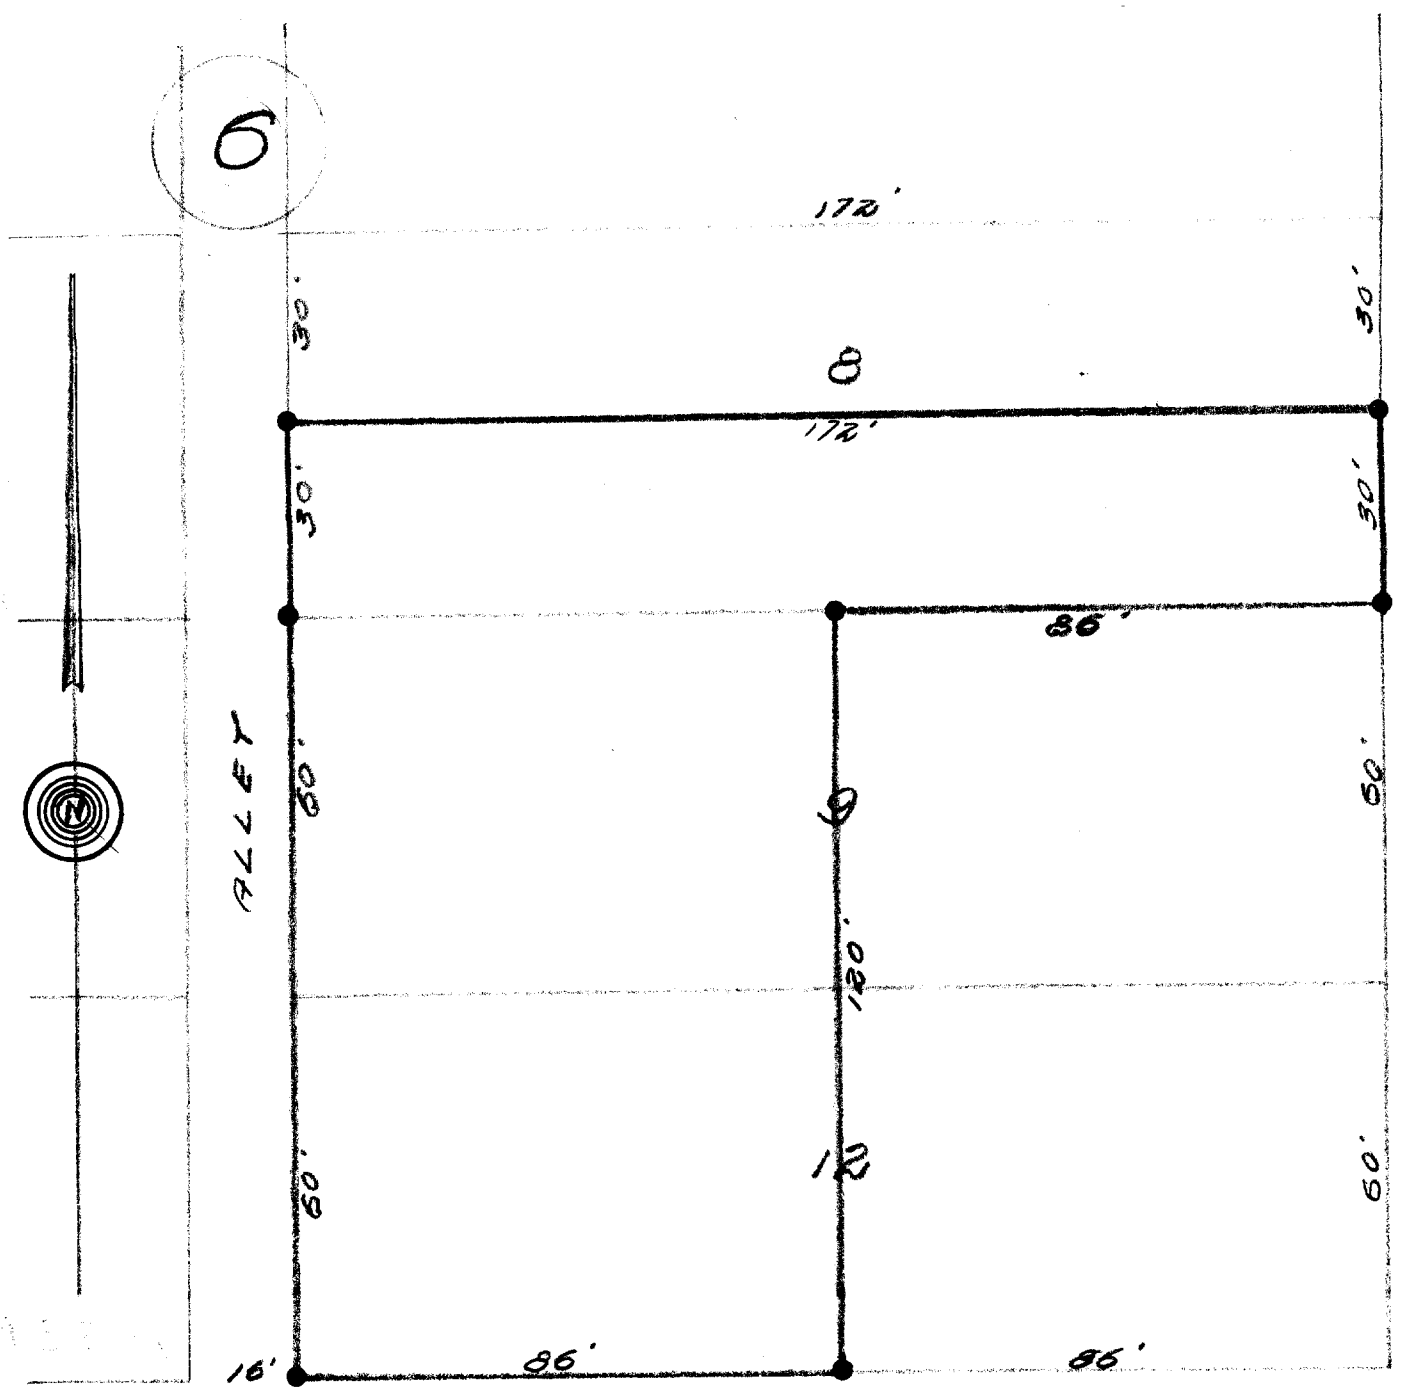


66'

47-14

STAGE ST.

GROVE ST.

66

DESCRIPTION:
The west one half of Lots 9 and 12 and the south one half of Lot 8; Block 6, Geneva Lake Crawford Manufacturing Addittion to the Village (now city) of Lake Geneva, Walworth County, Wisconsin.

CERTIFICATE: I, Joseph M. Biagi, Professional Engineer, do hereby certify that I have on this the 17th day of March 1947, surveyed the above described property according to the official records on file in the office of the Recorder of Deeds in and for Walworth County, Wisconsin, and find that no encroachments exist.
SIGNED AND SEALED THIS 18TH DAY OF MARCH 1947

Joseph M. Biagi Professional Engineer
Elkhorn Wisconsin.

GE-15 & 16

7-53B