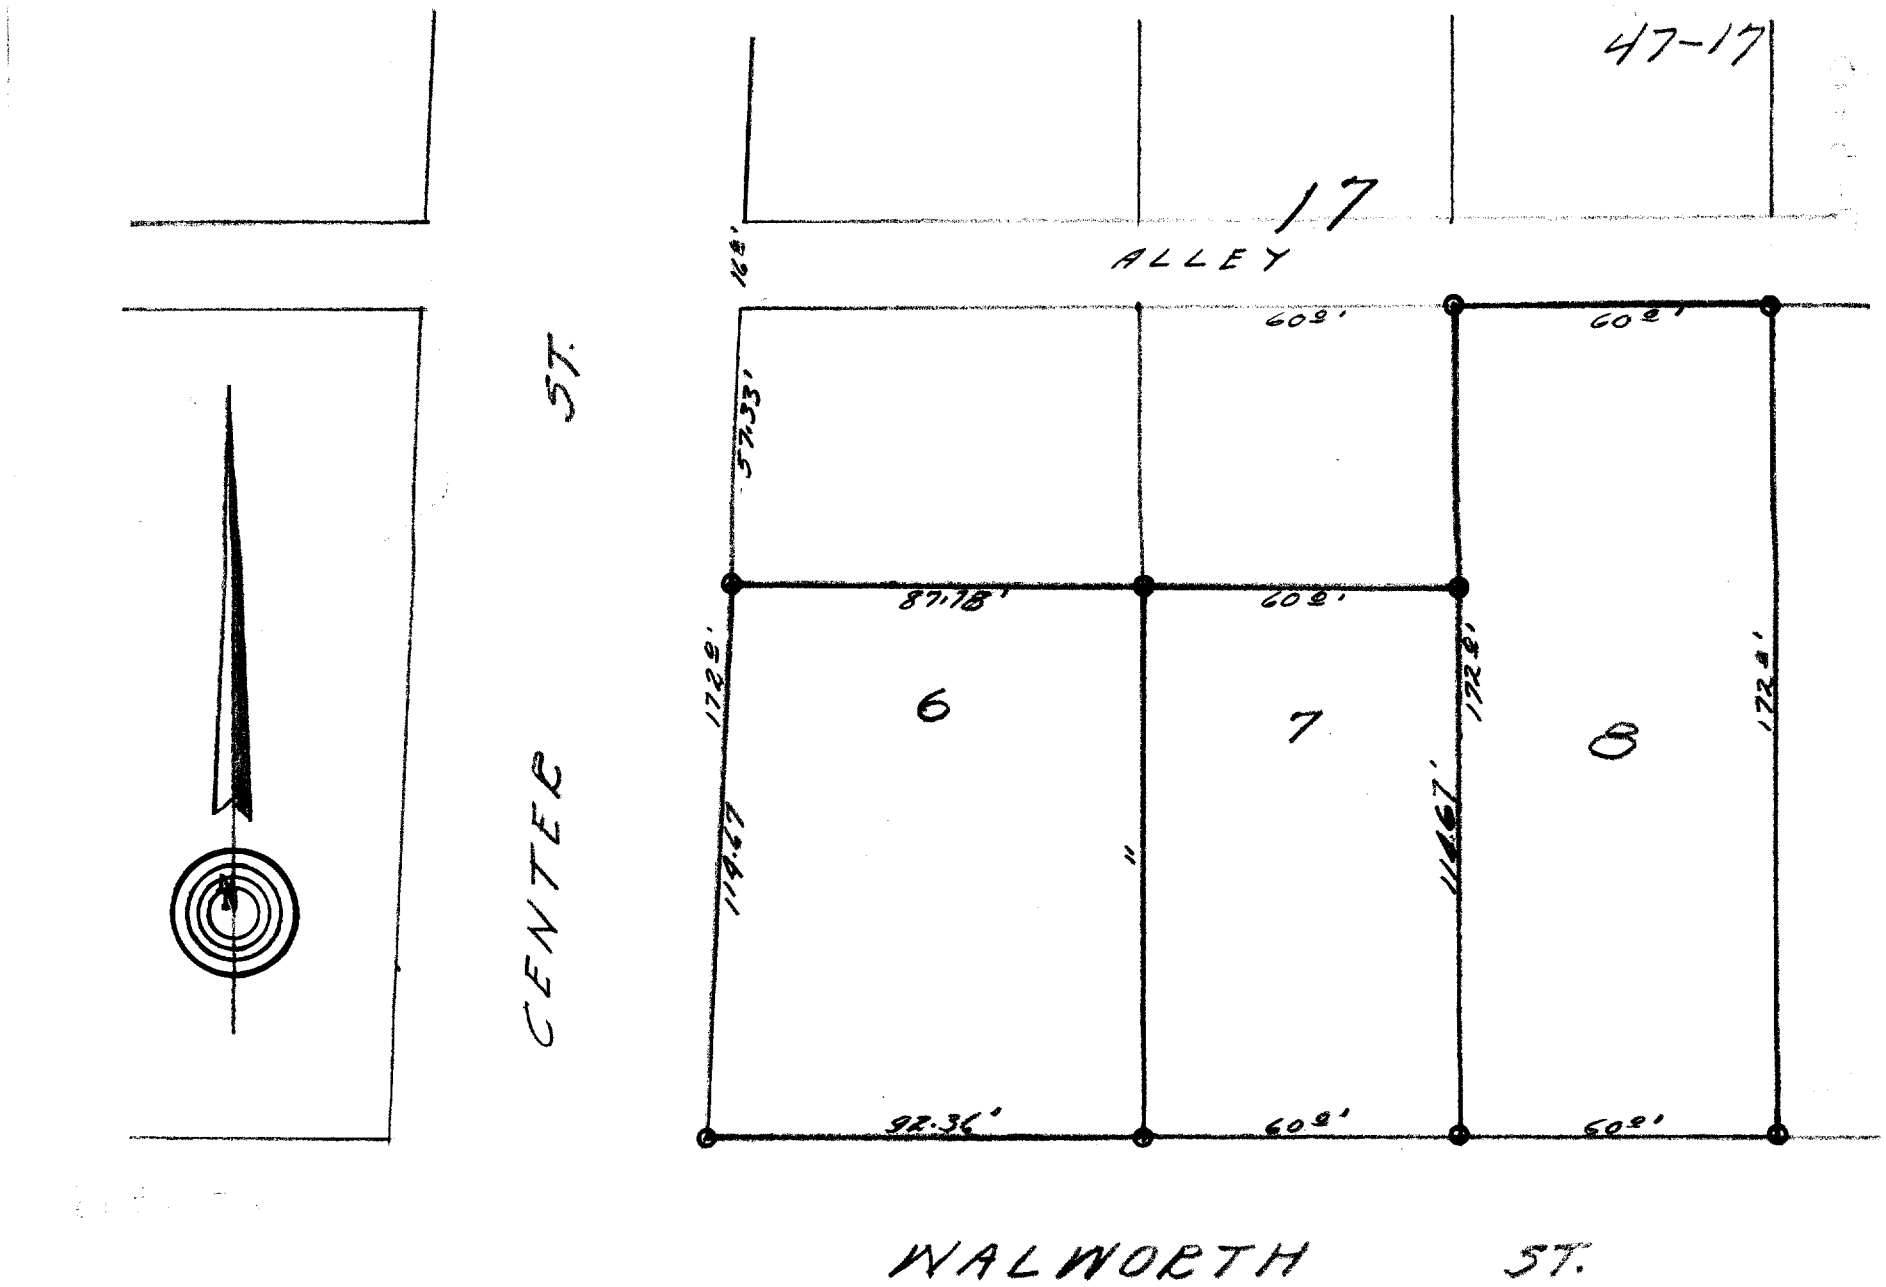

DESCRIPTION: The south 2/3 of Lots 6, & 7, and all of Lot 8; Block 17, Geneva Lake, Crawford Manufacturer's Addition to the City of Lake Geneva Walworth, County, Wisconsin.

Certificate: I, hereby certify, that I have on this the 21st day of October 1947, surveyed the above described property according to the official records on file in the office of the Recorder of Deeds in and for Walworth County, Wisconsin, and find that the measurements and bearings of the boundary lines of said property as taken at the site on this day substantially agree with those in the above description, and that no encroachments exist.

SIGNED AND SEALED THIS 03TH DAY OF OCTOBER 1947.

Joseph M. Biagi.

Joseph M. Biagi. Professional Engineer.
Elkhorn Wisconsin.

New cs no. 1

GC-86 + 87

7-54B