
HAROLD H. KOLB

REGISTERED PROFESSIONAL LAND SURVEYOR
LAKE GENEVA, WISCONSIN

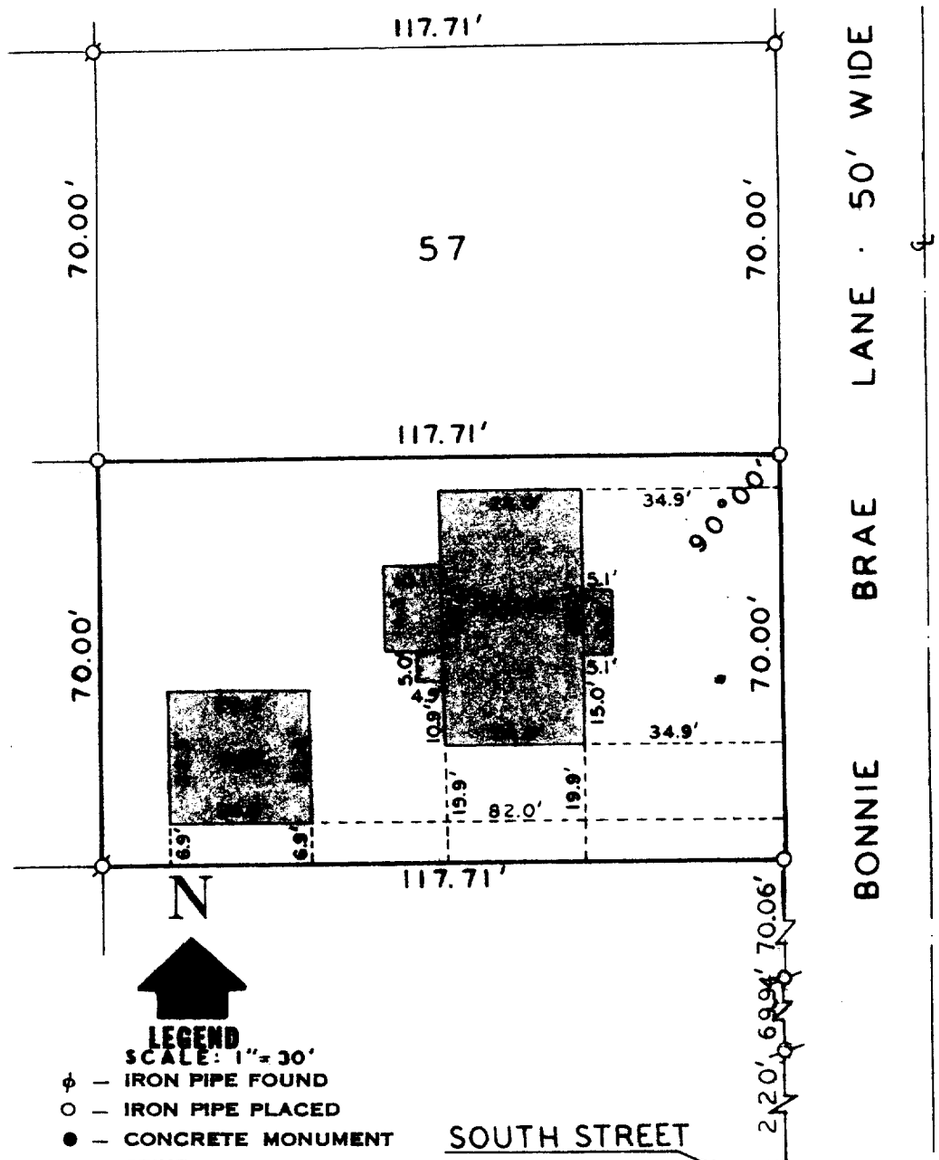

LEGEND
SCALE: 1" = 30'
ϕ — IRON PIPE FOUND
O — IRON PIPE PLACED
● — CONCRETE MONUMENT
x — SPIKE

I. HAROLD H. KOLB, DO HEREBY CERTIFY THAT I HAVE SURVEYED THE PROPERTY HEREON DESCRIBED ACCORDING TO THE OFFICIAL RECORDS. AND THAT THE PLAT HEREON IS A CORRECT REPRESENTATION OF THE LOT LINES.

HAROLD H. KOLB
WISCONSIN REGISTERED LAND SURVEYOR, S-187
DATE June 10, 1974

REVISED: MARCH 10, 1976 7-550

ZWS-56

BRUNING 40-105 1M-6-71