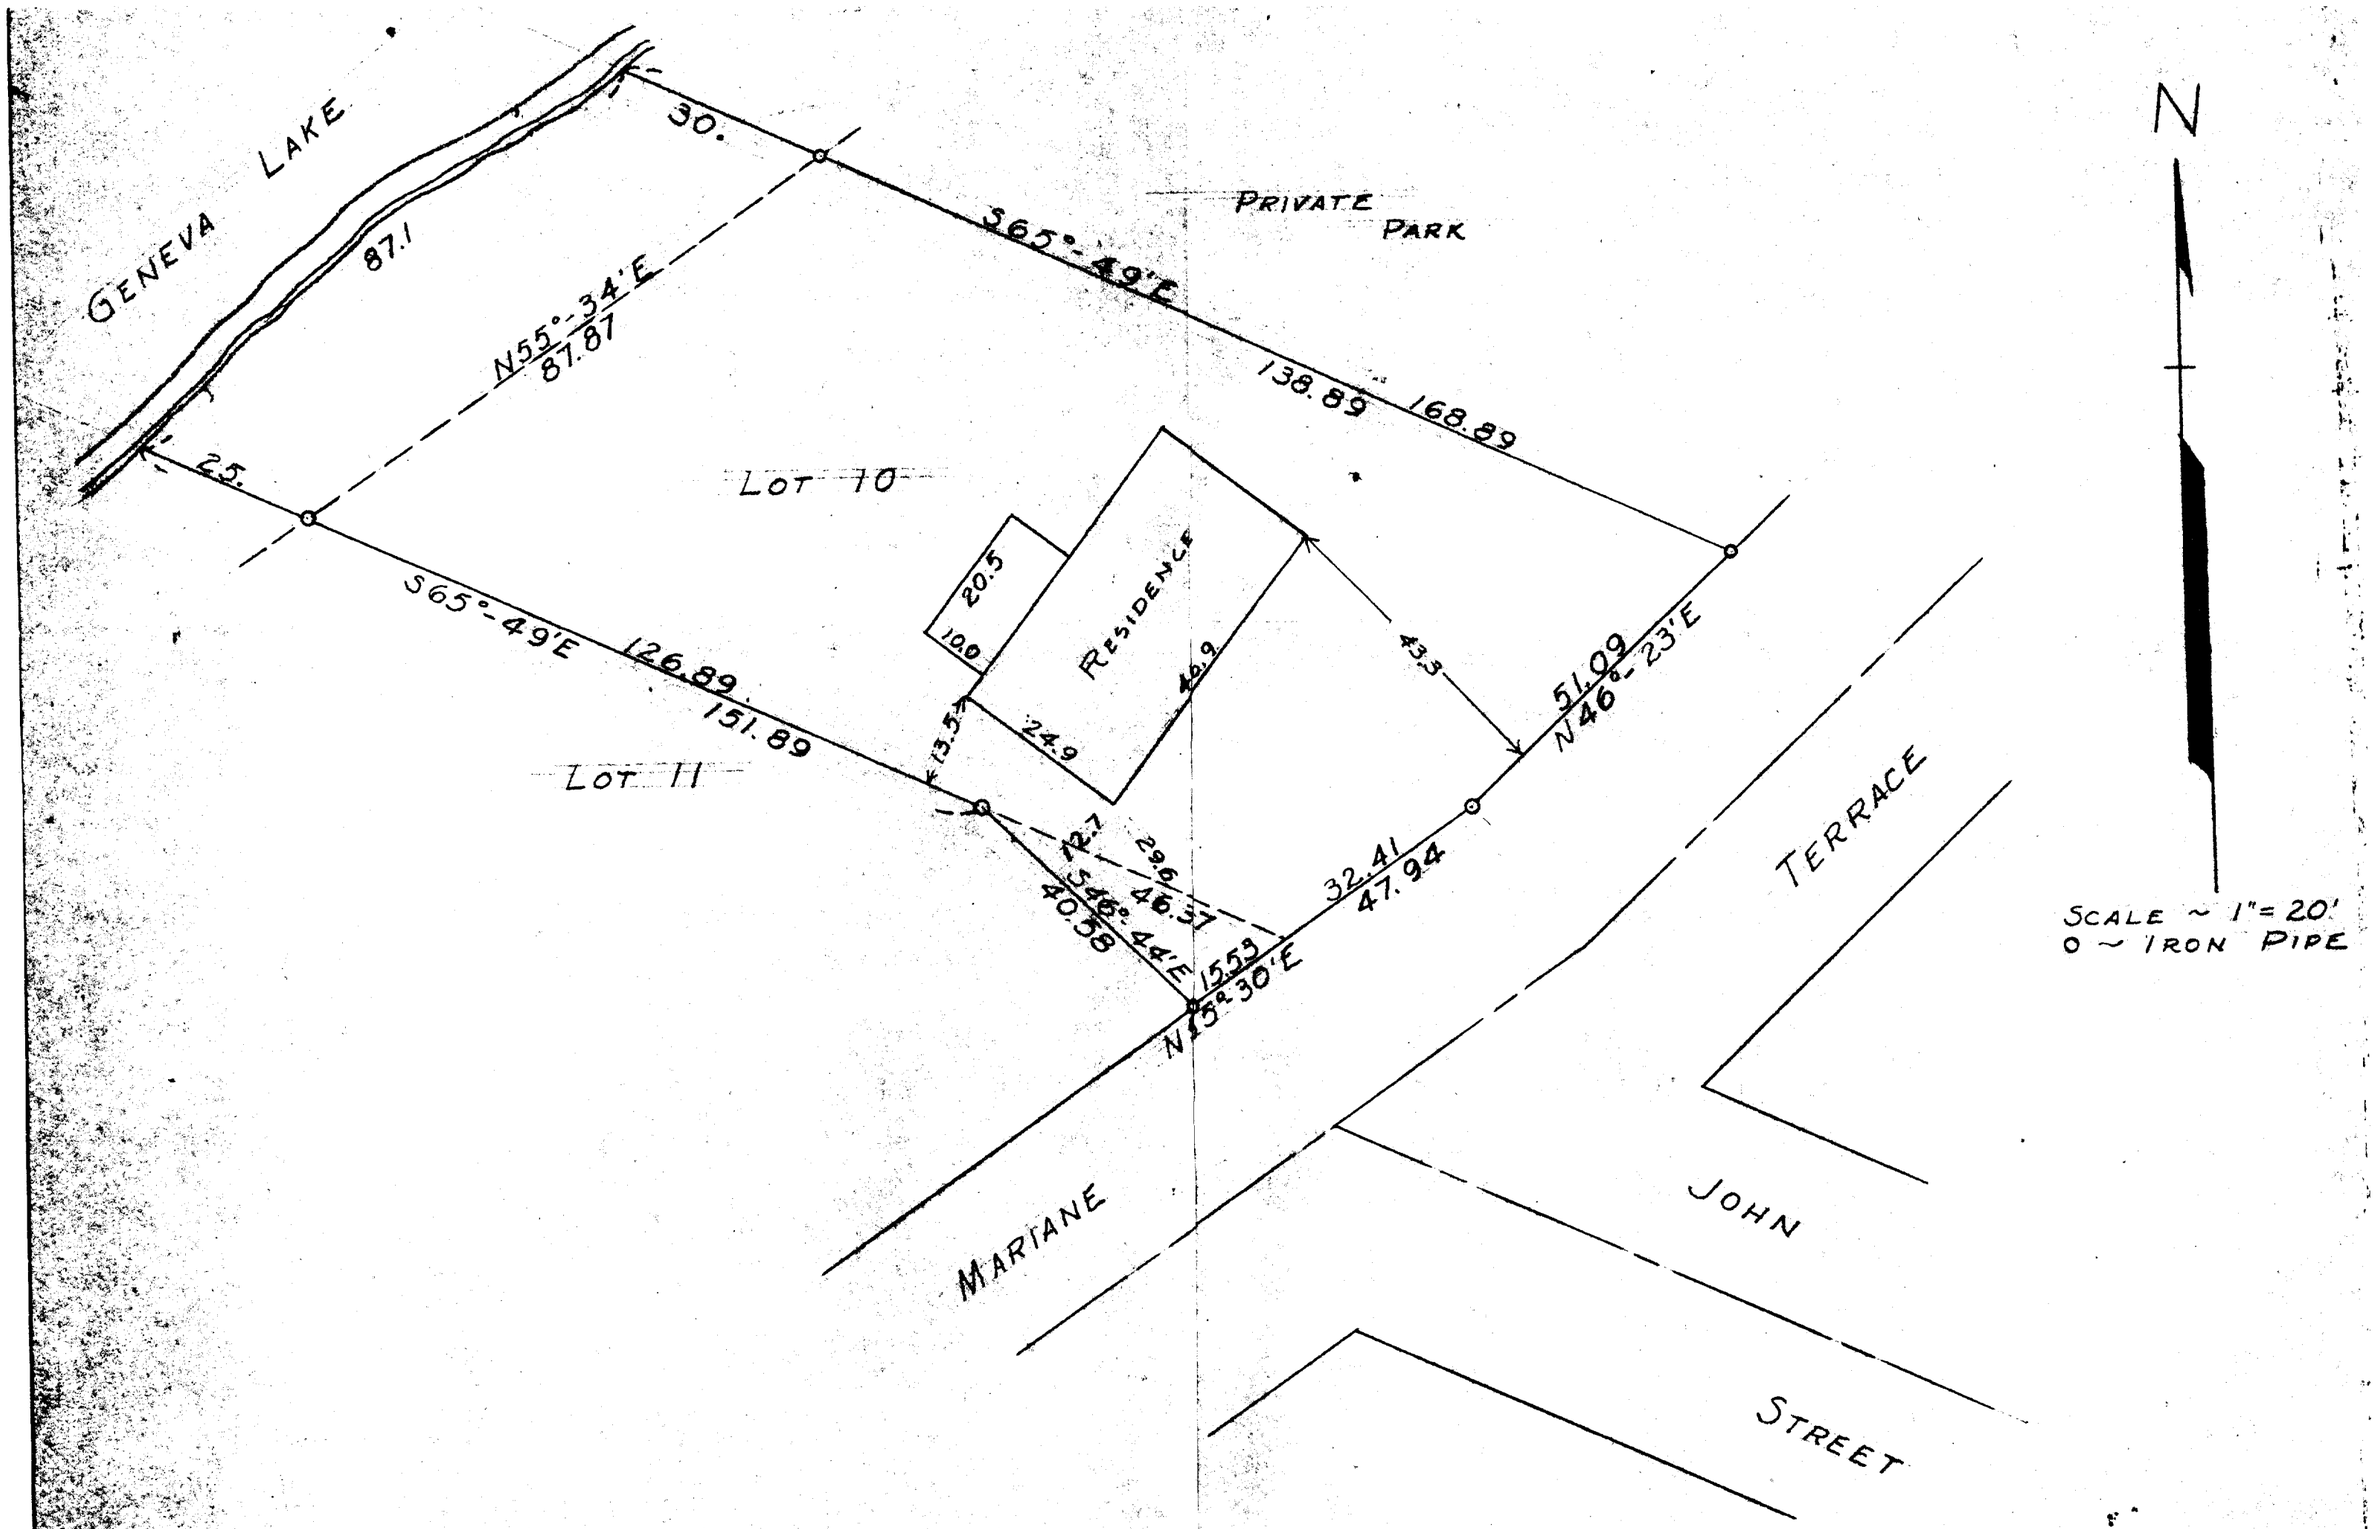

STATE OF WISCONSIN } S.S.
WALWORTH COUNTY }

I, GEORGE T. DUNHAM, DO HEREBY CERTIFY THAT I HAVE SURVEYED THE PROPERTY DESCRIBED AS FOLLOWS:

LOT 10 OF SYVER-STAD LAKE SHORE ESTATES, LOCATED IN THE CITY OF LAKE GENEVA, WALWORTH COUNTY, WISCONSIN, AND A PART OF LOT 11 OF SAID SYVER-STAD LAKE SHORE ESTATES, BEGINNING AT THE MOST EASTERLY CORNER OF SAID LOT 11; THENCE N65°-49'W ALONG THE NORTHEASTERLY LINE OF SAID LOT 11 46.37 FEET TO A POINT; THENCE S46°-44'E 40.58 FEET TO A POINT LOCATED S55°-30'W 15.53 FEET ALONG THE SOUTHEASTERLY LINE OF SAID LOT 11 FROM THE PLACE OF BEGINNING; THENCE N55°-30'E ALONG SAID SOUTHEASTERLY LINE 15.53 FEET TO THE PLACE OF BEGINNING.

AND THAT THE PLAT SHOWN ABOVE IS A CORRECT REPRESENTATION OF THE PROPERTY LINES AND OF THE IMPROVEMENTS LOCATED THEREON.

MARCH 19, 1958

George T. Dunham

GEORGE T. DUNHAM, SURVEYOR 7-56
DELAVAN, WISCONSIN.

SY-10