
HAROLD H. KOLB

REGISTERED PROFESSIONAL LAND SURVEYOR
LAKE GENEVA, WISCONSIN

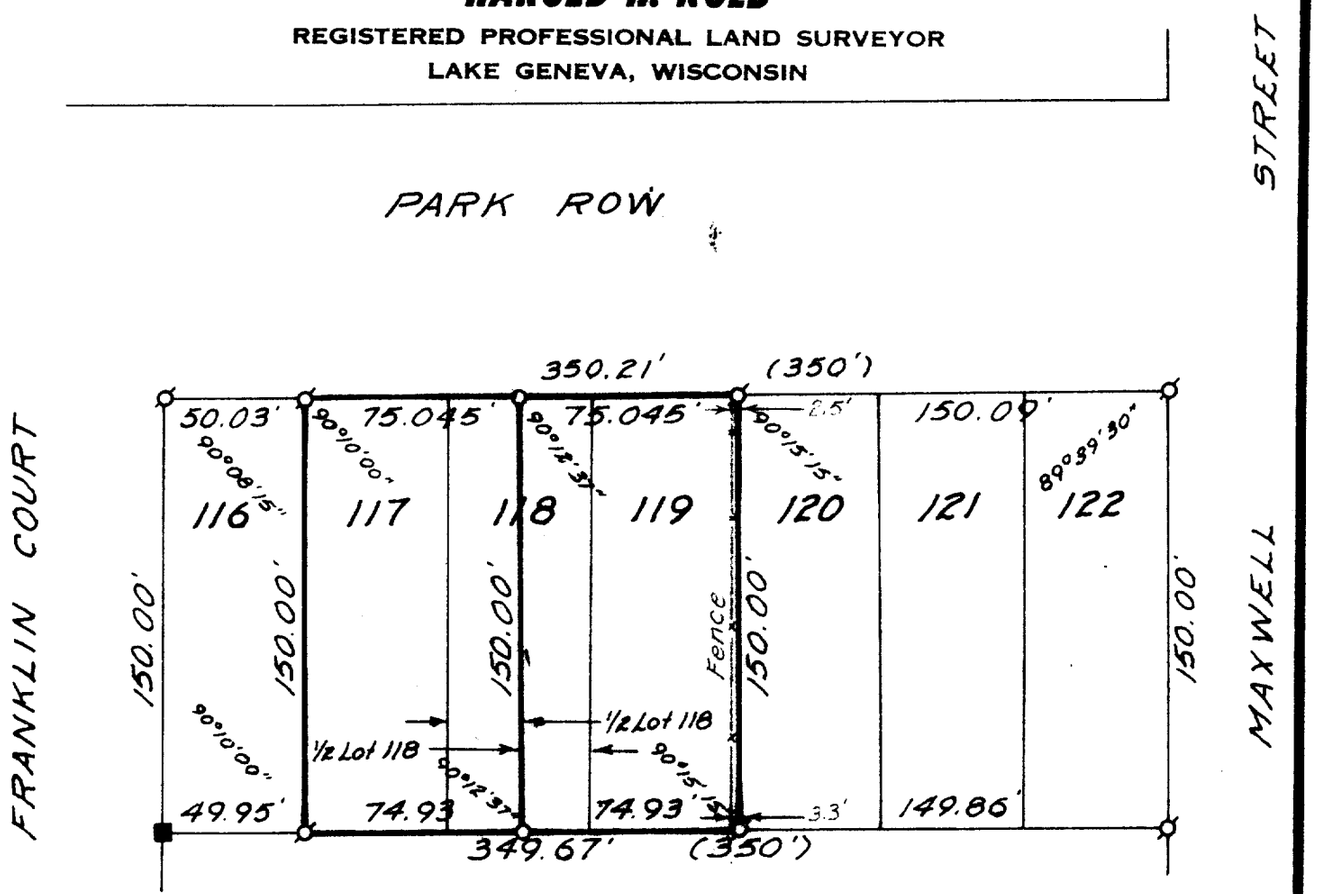

PLAT OF SURVEY OF

LOT 117 AND THE WEST 1/2 OF LOT 118, COLUMBIAN SUBDIVISION; AND LOT 119 AND THE EAST 1/2 OF LOT 118, COLUMBIAN SUBDIVISION, ALL IN THE CITY OF LAKE GENEVA, WALWORTH COUNTY, WISCONSIN.

ORDERED BY: HAROLD H. KOLB

ACCURACY: DISTANCES ± 0.01'
ANGLES ± 0°00'05
ERROR OF CLOSURE-- LESS THAN ONE PART IN 3000.

N

SCALE: 1" = 60'

LEGEND

- ϕ — IRON PIPE FOUND
- O — IRON PIPE PLACED
- ■ — CONCRETE MONUMENT FOUND
- ( ) — AS PLATTED

WISCONSIN
HAROLD H. KOLB
S-187
LAKE GENEVA, WIS.
LAND SURVEYOR

I. HAROLD H. KOLB, DO HEREBY CERTIFY THAT I HAVE SURVEYED THE PROPERTY HEREON DESCRIBED ACCORDING TO THE OFFICIAL RECORDS, AND THAT THE PLAT HEREON IS A CORRECT REPRESENTATION OF THE LOT LINES.

Harold H. Kolb

HAROLD H. KOLB
WISCONSIN REGISTERED LAND SURVEYOR, S-187
DATE AUGUST 21, 1976

7-568

BRUNING 40-105 1M-6-71 CL-89 + 89A