
52-23

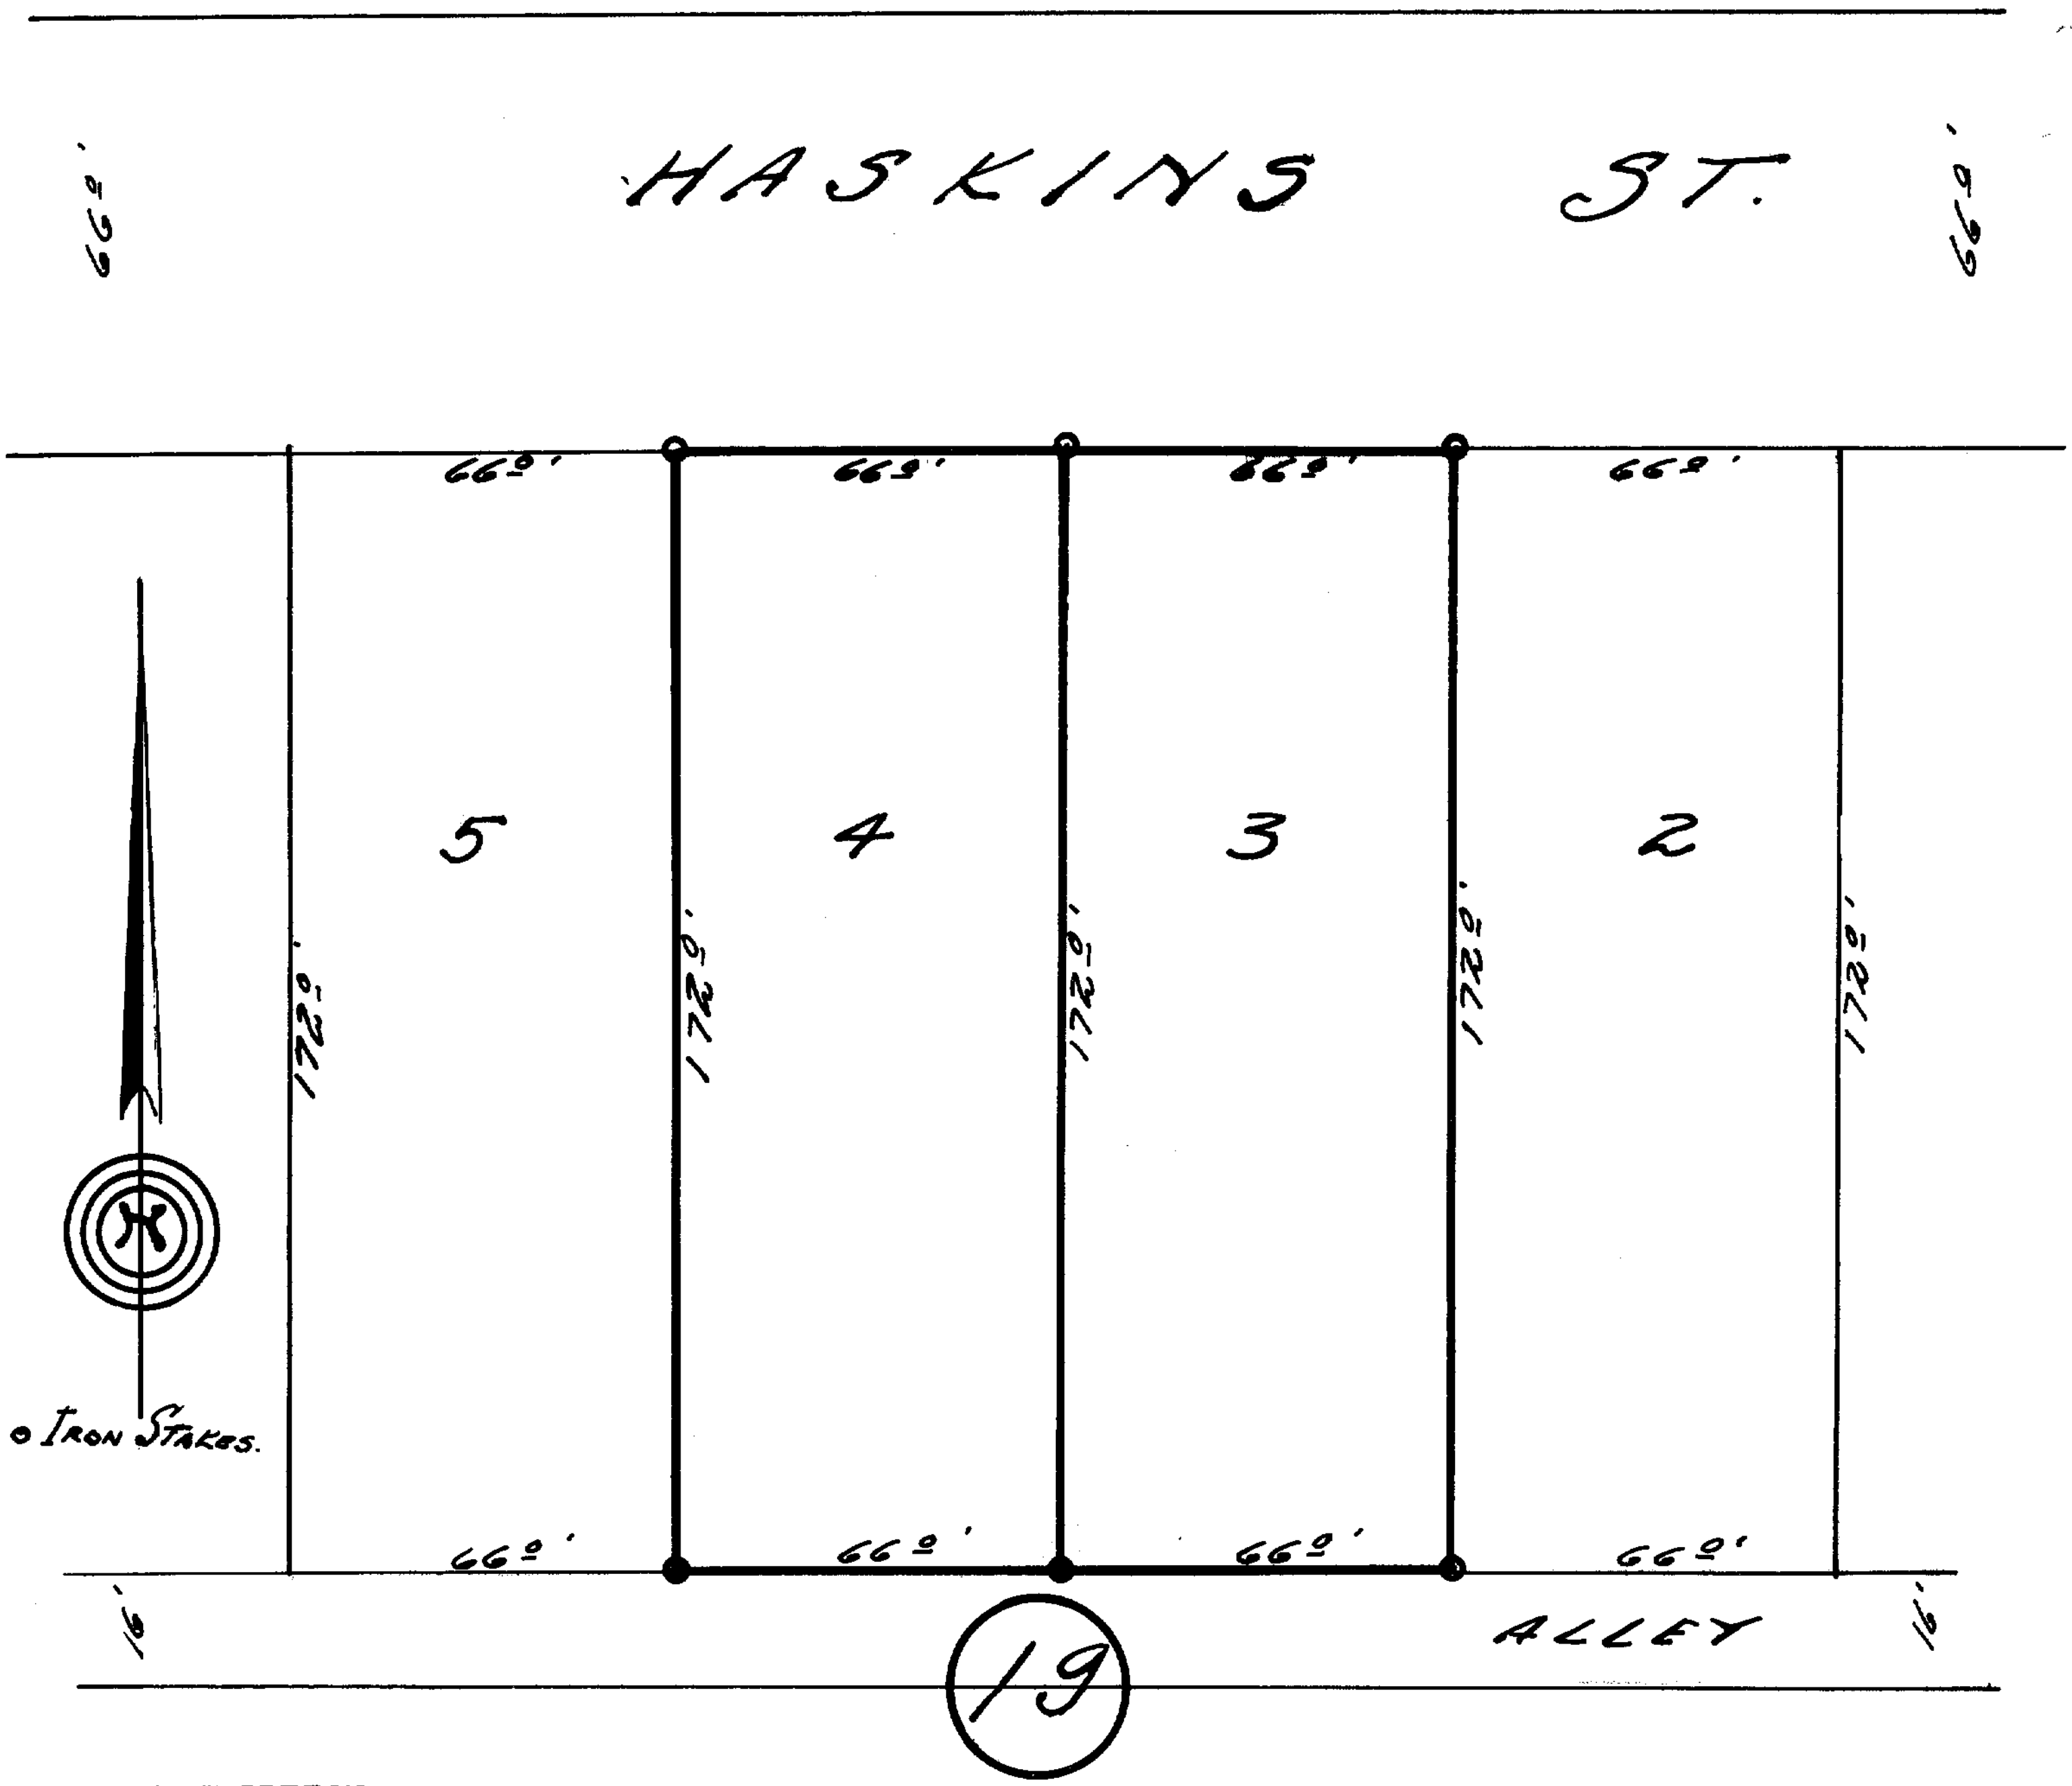

DESCRIPTION:

Lot 3 and Lot 4., Block 19, Geneva Lake Crawford Company Addition to the City of Lake Geneva, Walworth County, Wisconsin.

CERTIFICATE:

I, hereby certify that I have on this the 29th day of March 1952, surveyed the above described property according to the official plat on file in the office of the Recorder of Deeds in and for Walworth County, Wisconsin and find that the measurements and bearings of the boundary lines of said property as taken at the site on this day, substantially agree with those on said official plat and that no encroachments exist.

SIGNED AND SEALED THIS 1ST DAY OF APRIL 1952.

Joseph M. Biagi

Joseph M. Biagi. Professional Engineer
Elkhorn Wisconsin.

ZGC-103.1037

7-59B