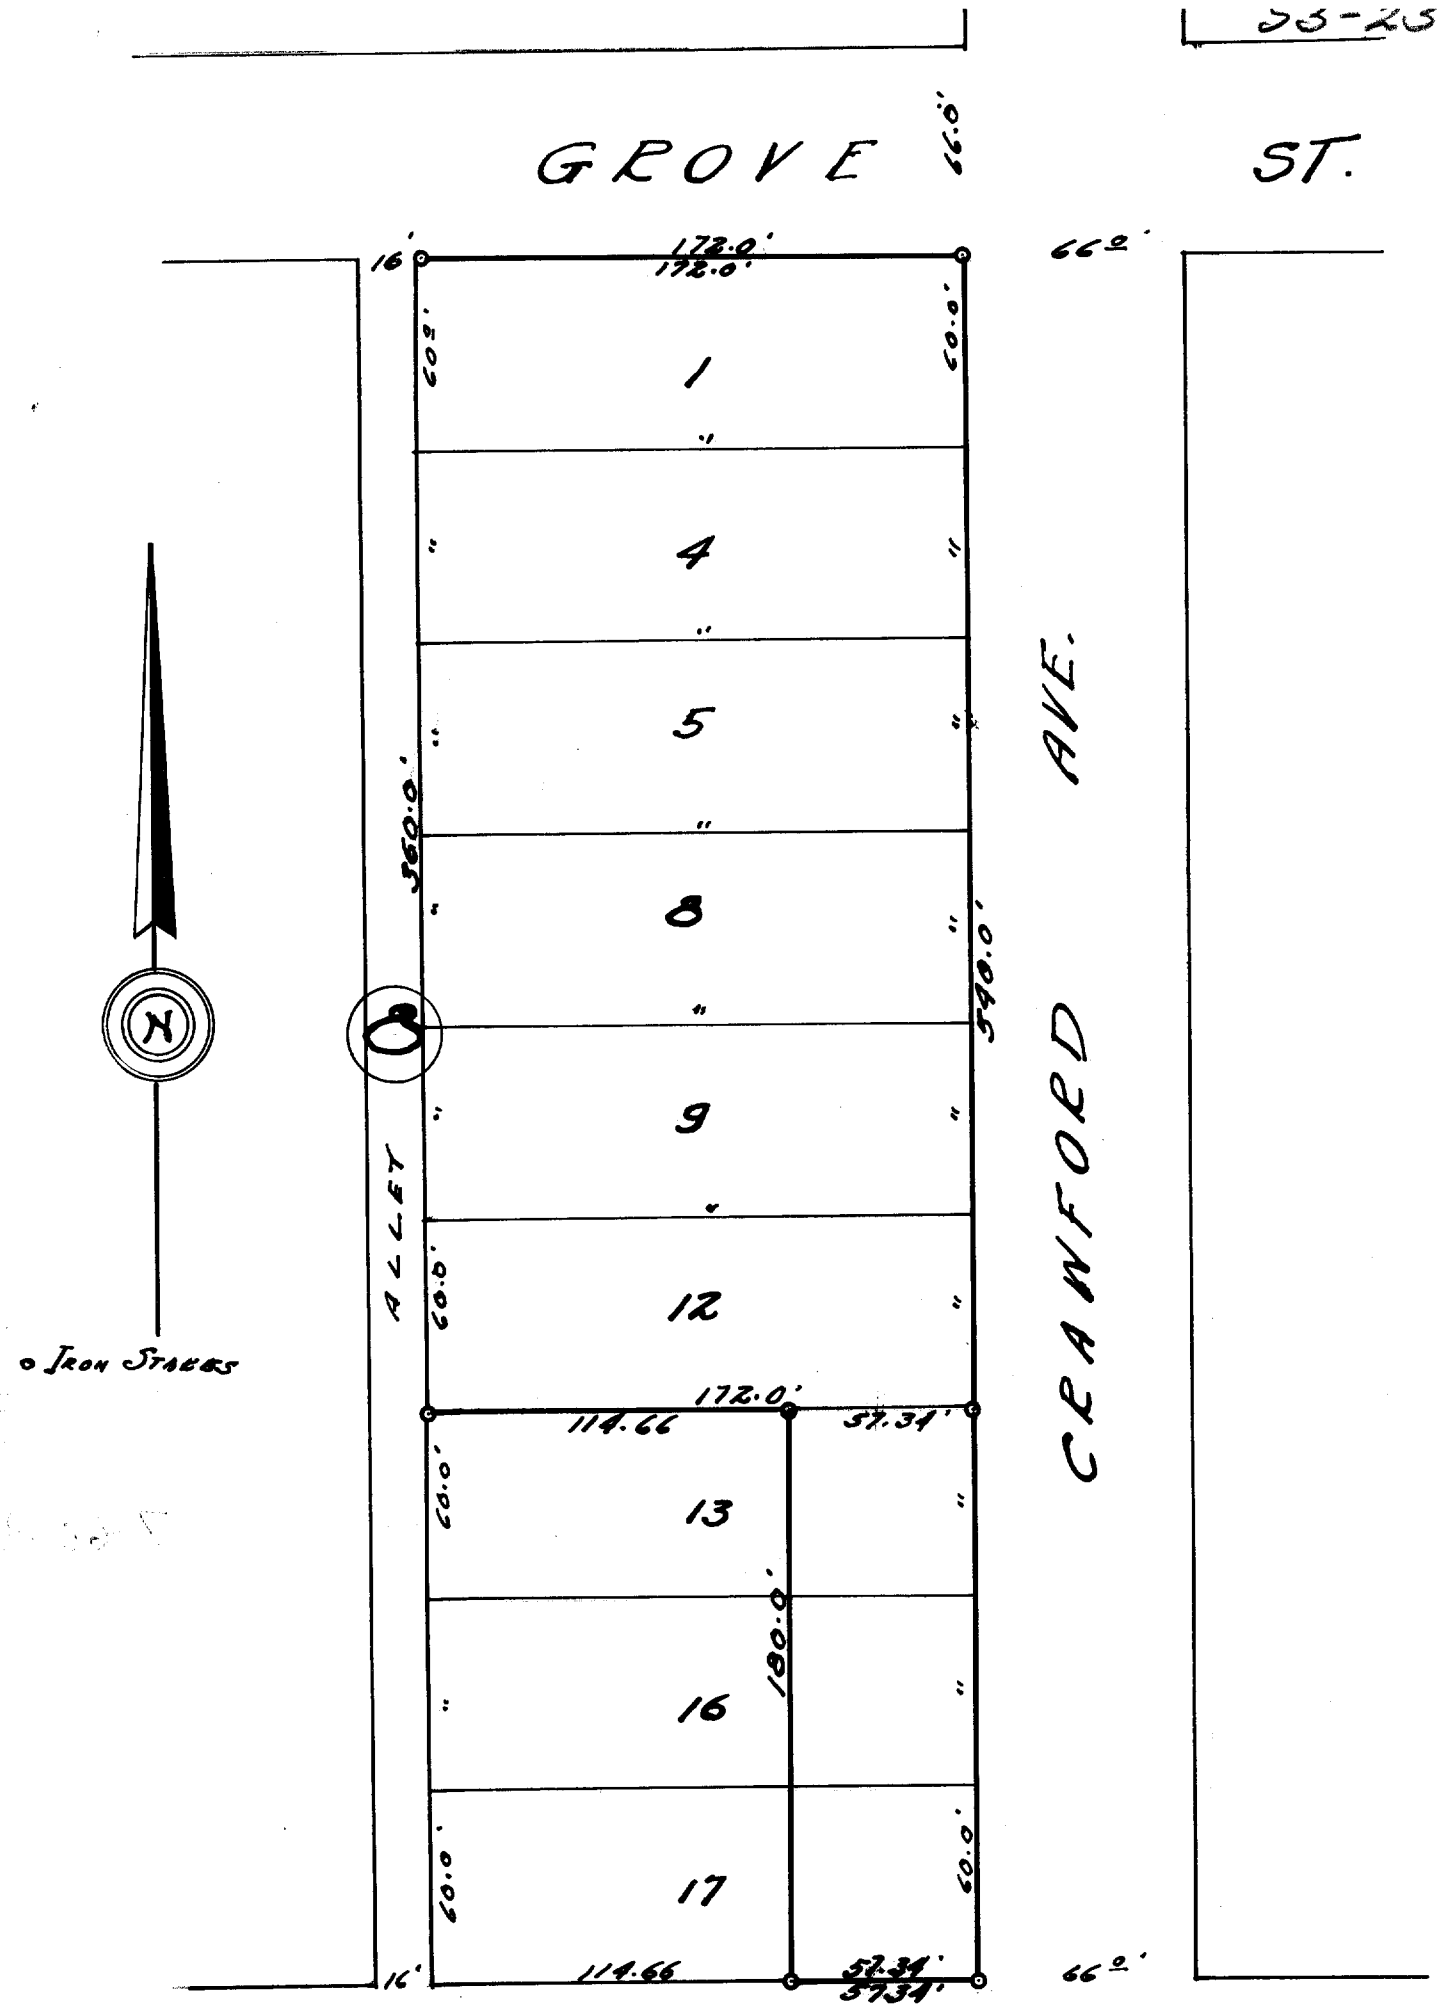


DESCRIPTION:

The east 57.34 feet of Lots 13, 16 & 17 Block 8 Geneva Lake Crawford Manufacturing Company Addition to the Village of (now city of) Lake Geneva Walworth County Wisconsin, also Lots 1, 4, 5, 8, 9, & 12 Block 8 in said Geneva Lake Crawford Manufacturing Company Addition.

CERTFICATE:

I, hereby certify that I have surveyed on this the 28th day of July 1953, and find that no encroachments exist.

SIGNED AND SEALED ON THIS THE 4TH DAY OF AUGUST 1953.

Joseph M. Biagi. Professional Engineer.
Elkhorn Wisconsin.

7-60B

GC-304 and 30