


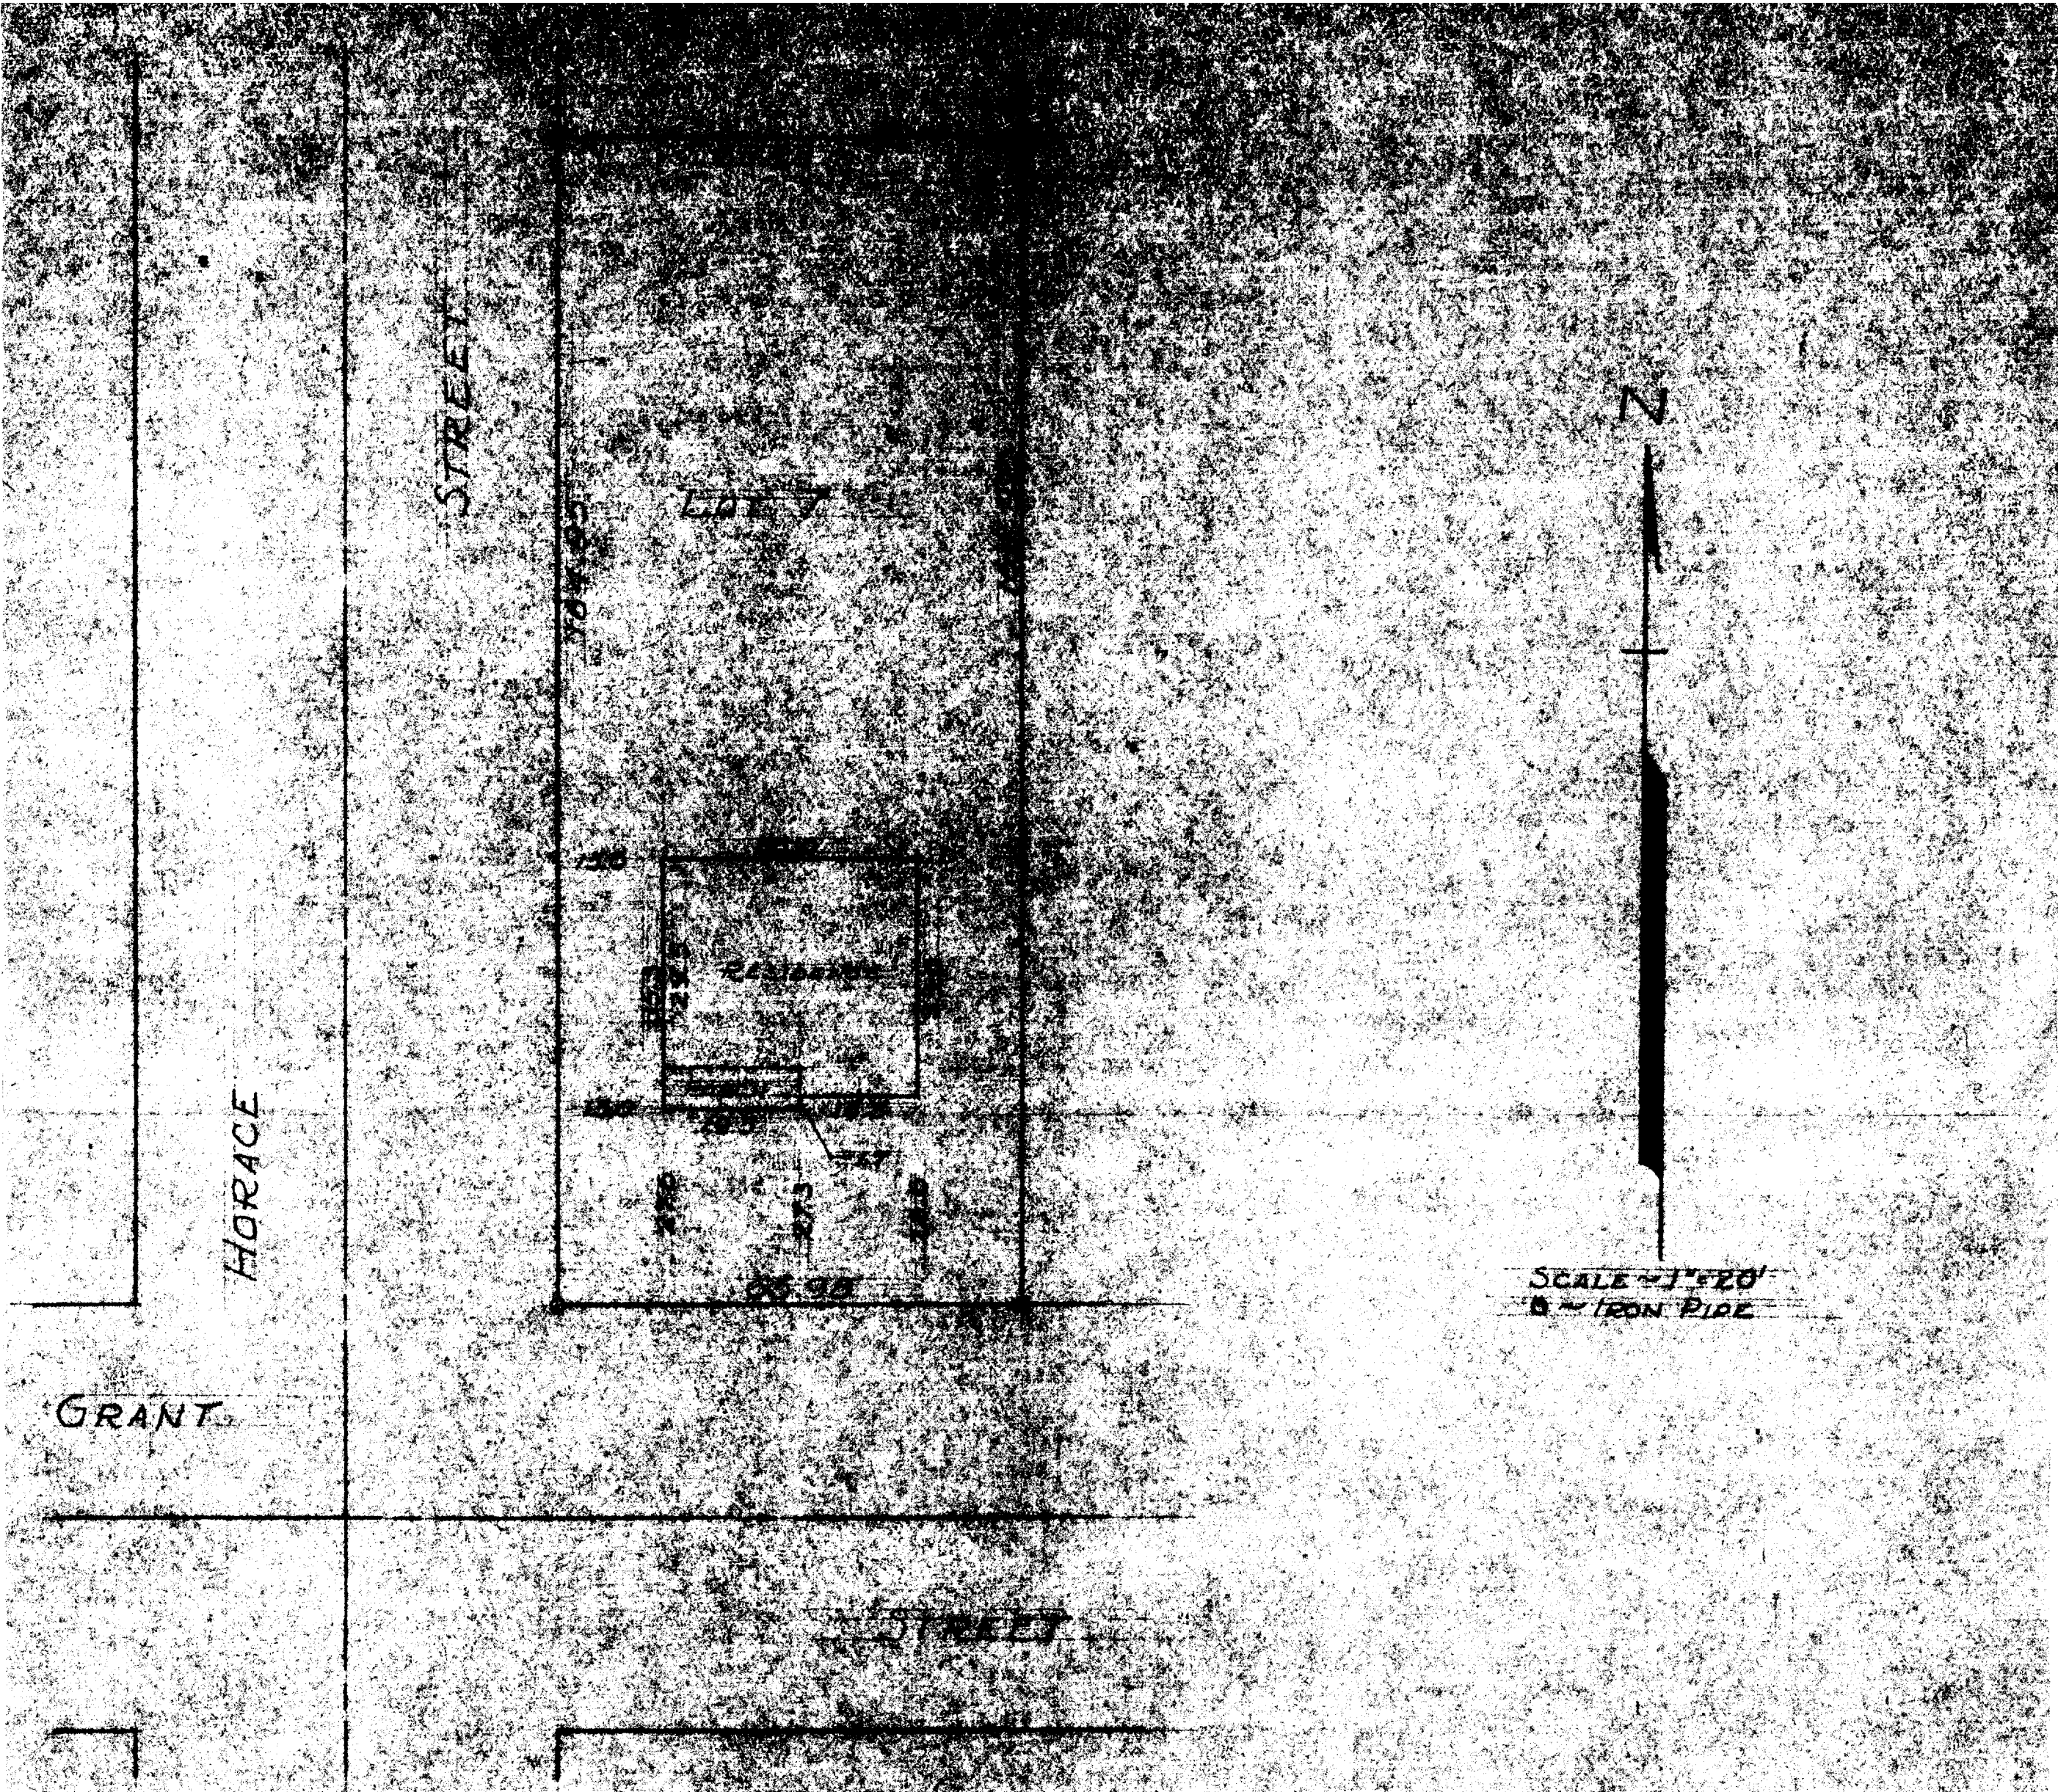

STATE OF WISCONSIN }
COUNTY OF WALWORTH } ss.
I, GEORGE T. DUNNIN, DO HEREBY CERTIFY THAT I HAVE SURVEYED THE PROPERTY
DESCRIBED AS FOLLOWS:
LOT 7, BLOCK 1, VILLAGE OF LAKE GENEVA, WISCONSIN.
AND THAT THE PLAT ABOVE IS A TRUE AND CORRECT REPRESENTATION OF THE PROPERTY
LINES AND IMPROVEMENTS AS SURVEYED AND PLATTED
SEPTEMBER 7, 1907

George T. Dunnin
GEORGE T. DUNNIN, SURVEYOR
GENEVA, WISCONSIN

2 lot 3