
3-67

℄ SPRING STREET. ℄

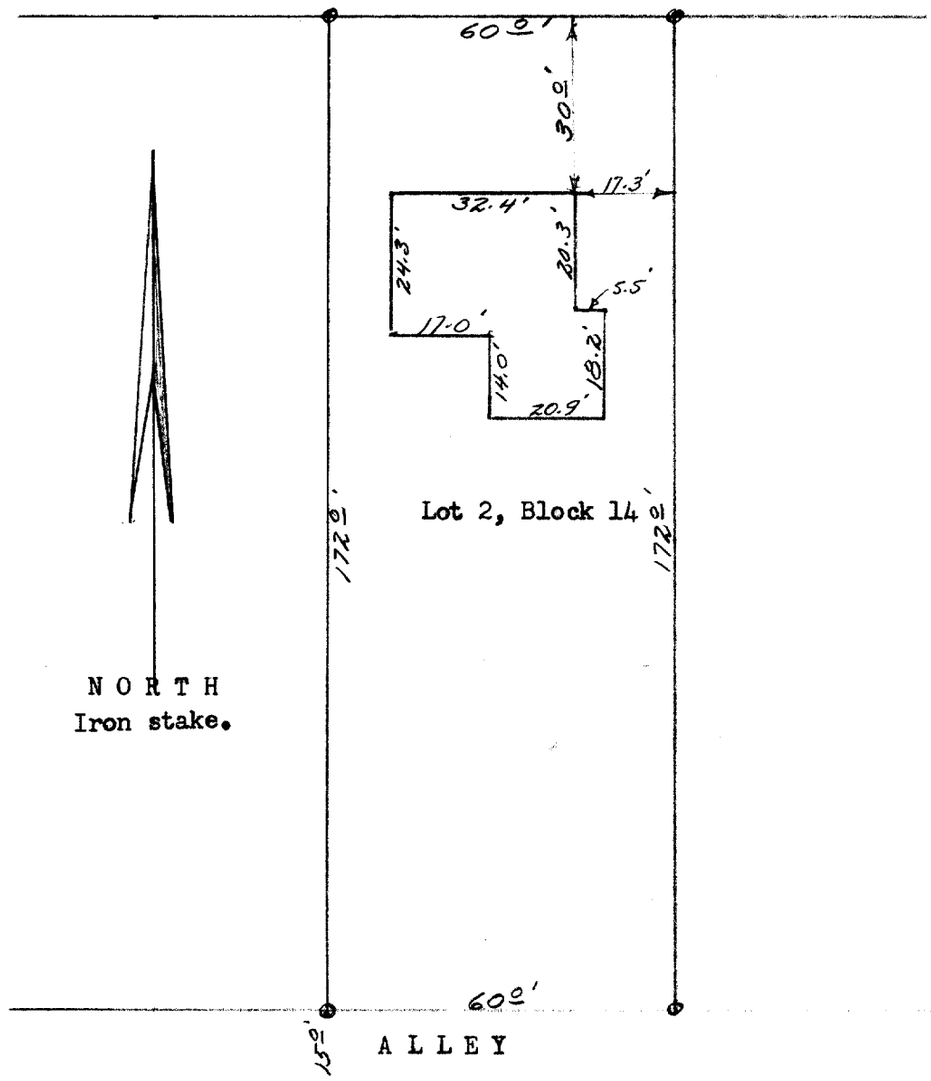

DESCRIPTION: Lot 2 Block 14 in Geneva Lake Crawford Manufacturing Company's Addition to the Village of Geneva, now City of Lake Geneva, Walworth County, Wisconsin.

CERTIFICATE: I hereby certify that I have surveyed the above mentioned property and that the hereon portrayed is an accurate survey and a true representation thereof and correctly shows the exterior boundary lines and the location of the buildings and the other improvements thereof.

James F. Blagi RLS 272
Elkhorn, Wisconsin.

Dated January 24th 1967.

JAMES F. BLAGI

Zoc 554

7-62B