
#136-72

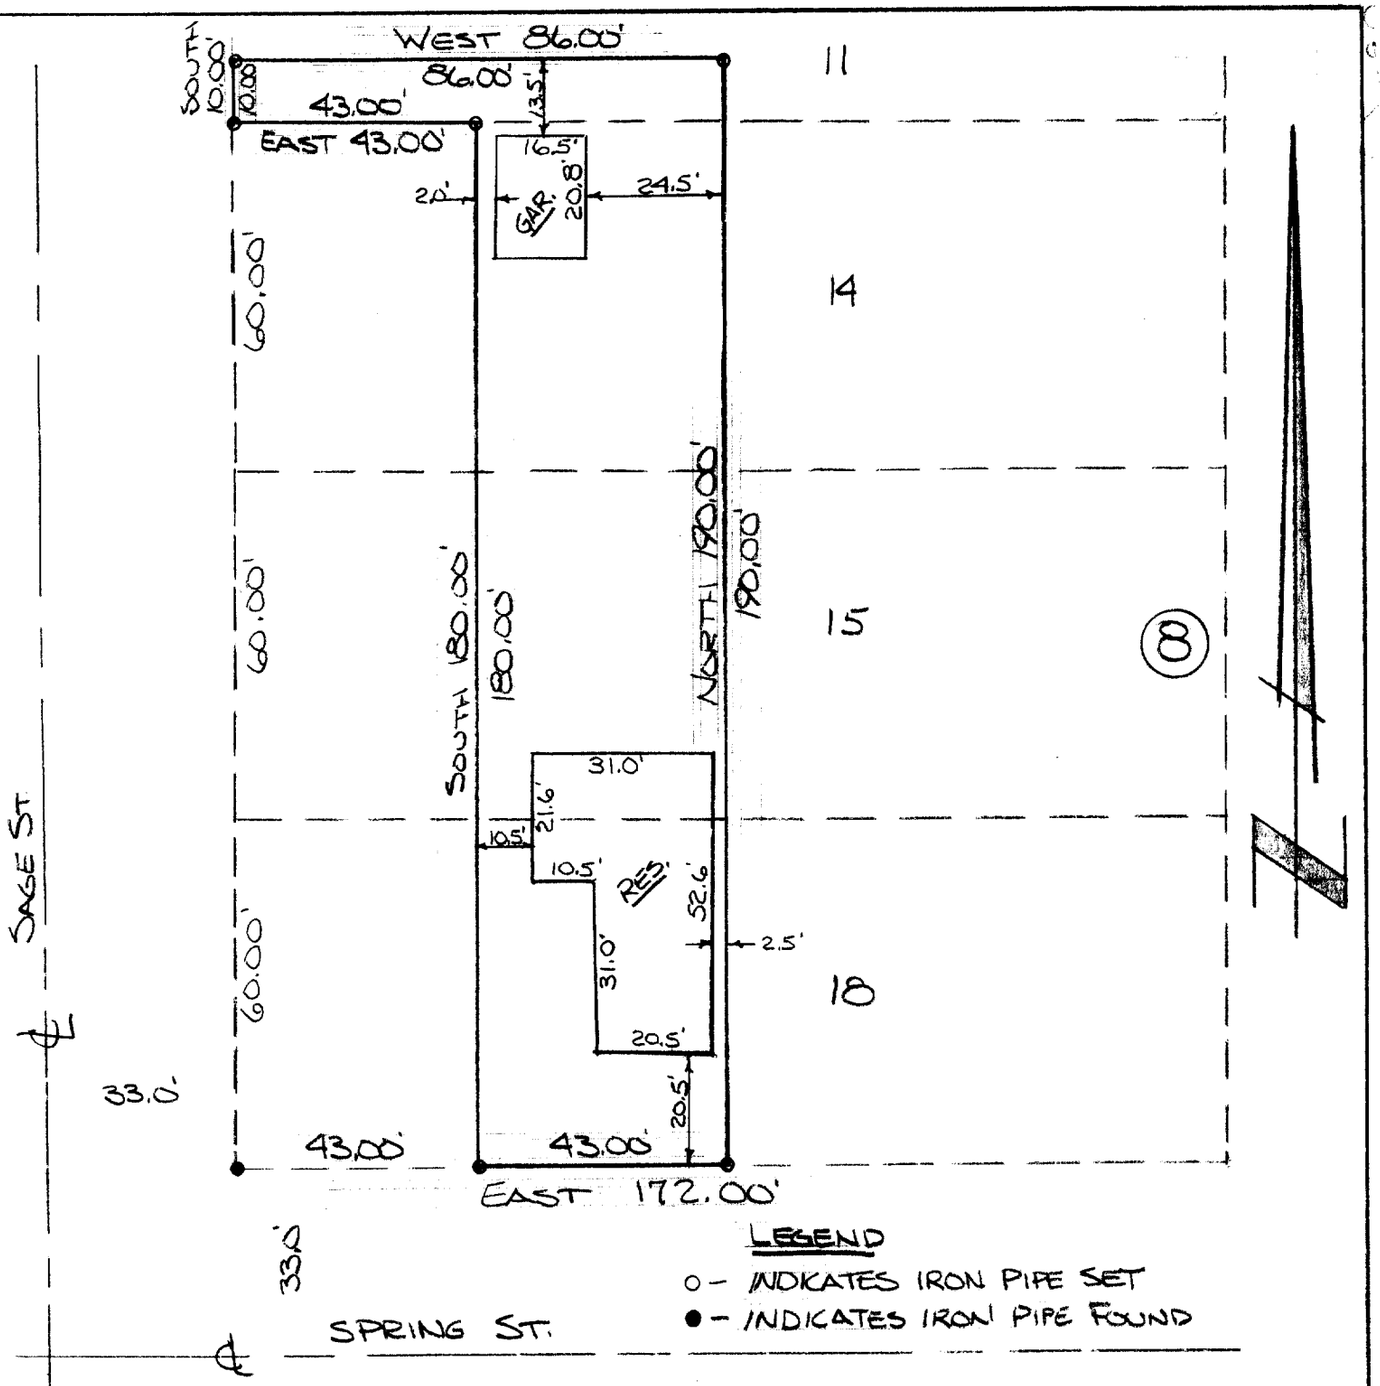

DESCRIPTION:
A parcel of land located in the City of Lake Geneva, Walworth County, Wisconsin described as follows to-wit; The South 10.00 feet of the West 86.00 feet of lot 11, block 8 and the East 43.00 feet of the West 86.00 feet of lots 14, 15, and 18 block 8, all located in Geneva Lake Crawford Mfg. Add.

CERTIFICATE:
I, Joseph M. Biagi, surveyor, do hereby certify that I have surveyed the property hereon described.

DATE:
November 22, 1972

Joseph M. Biagi. RLS#12

GC-35

7-63B