
HAROLD H. KOLB

REGISTERED PROFESSIONAL LAND SURVEYOR
LAKE GENEVA, WISCONSIN

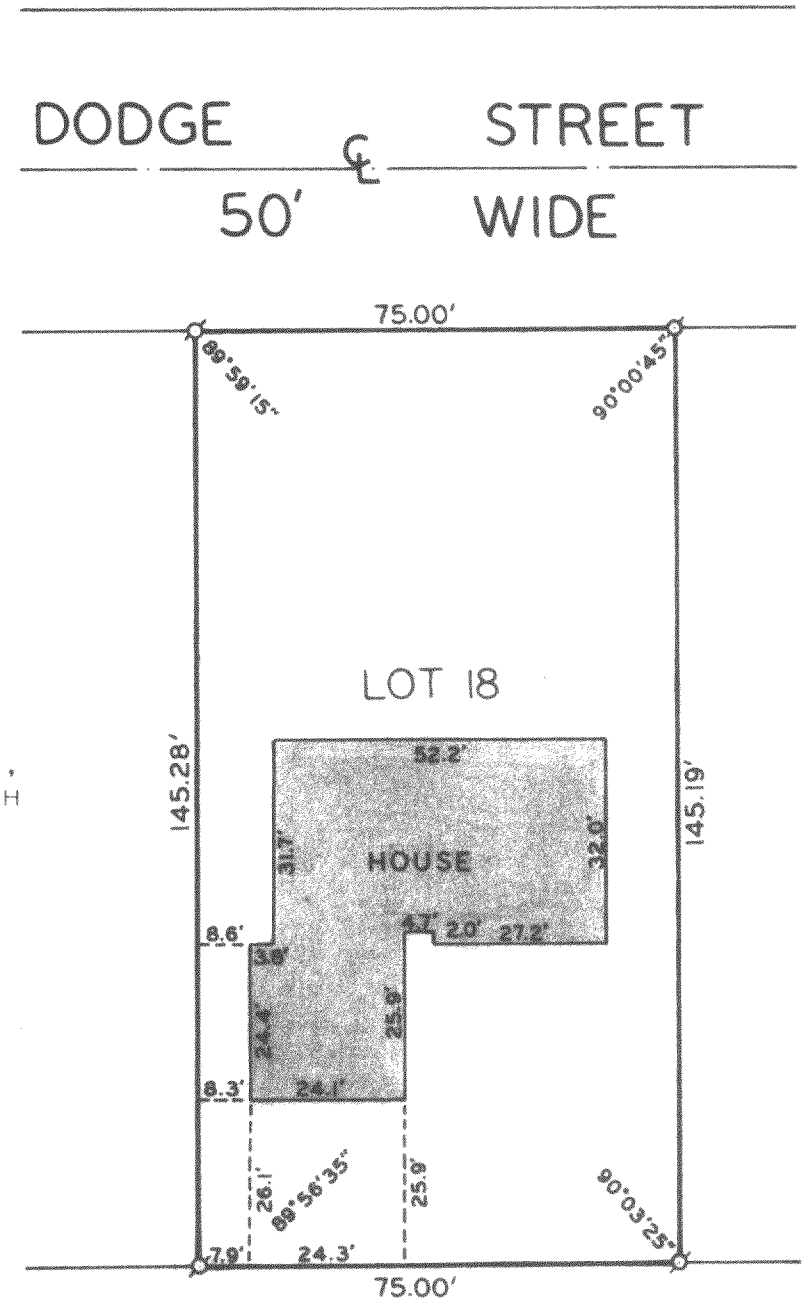

MILLER ℄ COURT
50' WIDE

PLAT OF SURVEY OF

LOT 18, WESTGATE SUBDIVISION, CITY OF LAKE GENEVA, WALWORTH COUNTY, WISCONSIN.

ORDERED BY: JIM O'BRIEN

WISCONSIN HAROLD H KOLB S-187 LAKE GENEVA WIS. LAND SURVEYOR

I, HAROLD H. KOLB, DO HEREBY CERTIFY THAT I HAVE SURVEYED THE PROPERTY HEREON DESCRIBED ACCORDING TO THE OFFICIAL RECORDS, AND THAT THE PLAT HEREON IS A CORRECT REPRESENTATION OF THE LOT LINES.

Harold H. Kolb
HAROLD H. KOLB
WISCONSIN REGISTERED LAND SURVEYOR, S-187
DATE Jan. 30, 1978

N

SCALE : 1" = 30'

LEGEND

O — IRON PIPE PLACED. 1" x 24" 1.13 LB./LIN. FT.
● — CONCRETE MONUMENT. 5" DIA. x 30"
ø — IRON PIPE FOUND.

BRUNING 40-105 1M-6-71

7-641K