
KOLB LAND CONSULTING, INC.

LAND SURVEYING · SUBDIVIDING · LAND PLANNING

LAKE GENEVA, WISCONSIN 53147 — WHITEWATER, WISCONSIN 53190

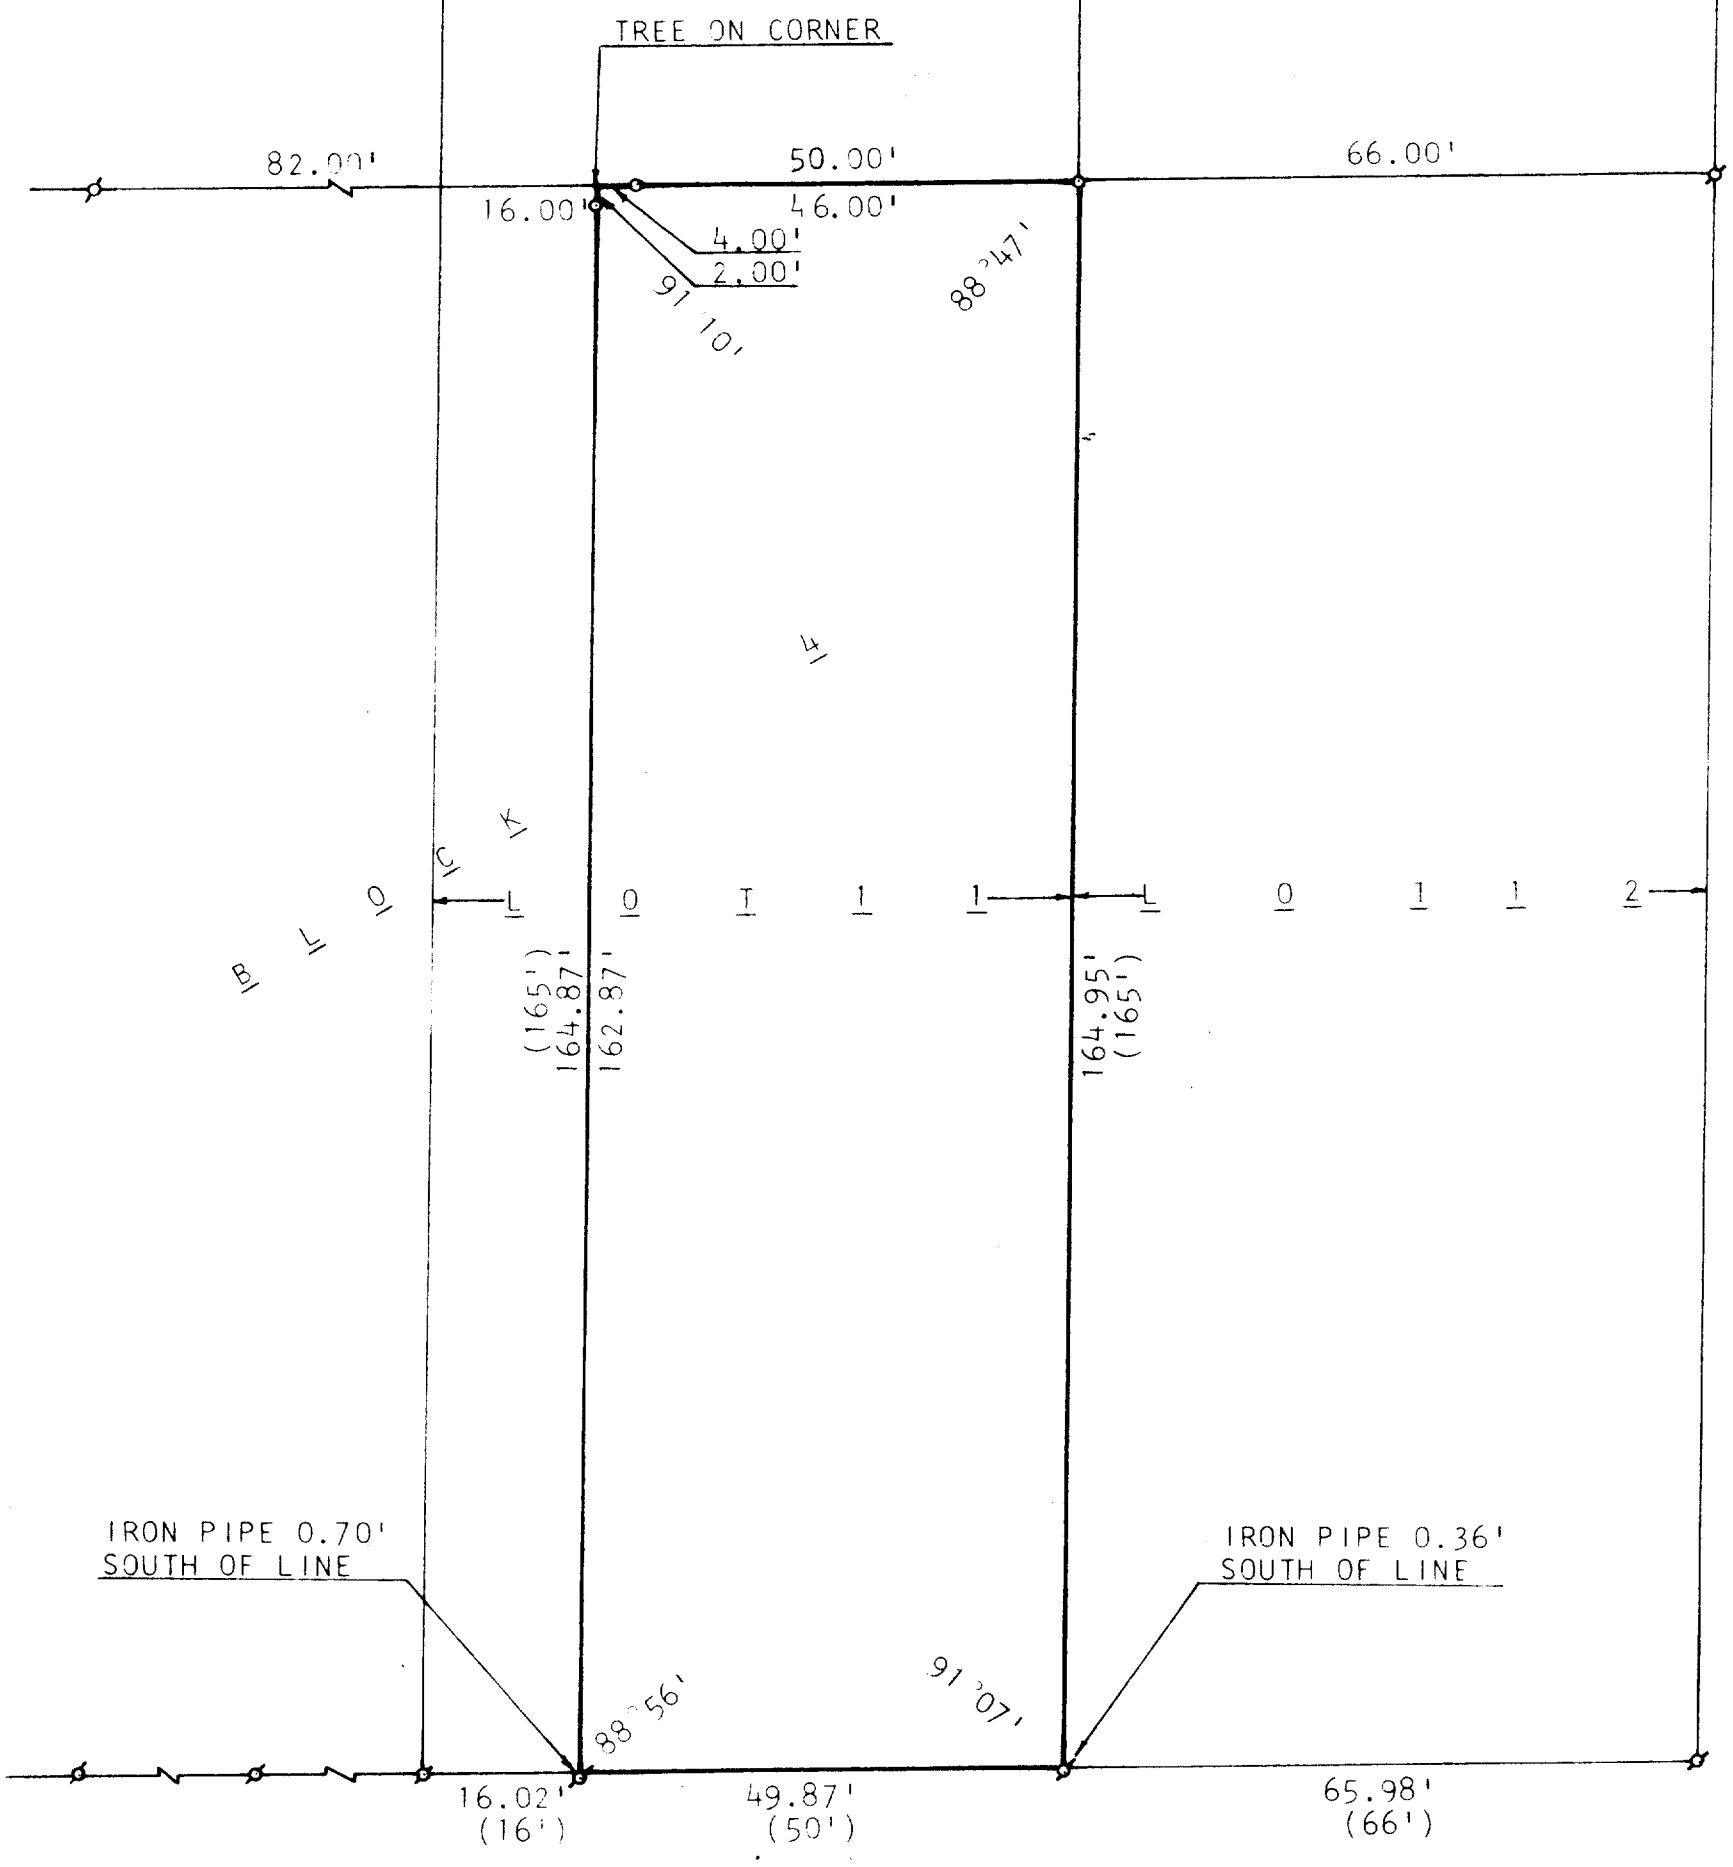

WHEELER STREET 60' WIDE

PLAT OF SURVEY OF

THE EAST 50' OF LOT 11, BLOCK 4, WHEELERS ADDITION TO THE CITY OF LAKE GENEVA, WALWORTH COUNTY, WISCONSIN.

ORDERED BY: RICHARD BRUGGER, ATTY.
719 GENEVA ST.
LAKE GENEVA, WIS. 53147

SCALE: 1"=20'

⌀ - IRON PIPE FOUND
o - IRON PIPE PLACED
( ) - RECORDED AS

WISCONSIN HAROLD H. KOLB S 187 LAKE GENEVA, WIS. LAND SURVEYOR

I, HAROLD H. KOLB, DO HEREBY CERTIFY THAT I HAVE SURVEYED THE PROPERTY HEREON DESCRIBED ACCORDING TO THE OFFICIAL RECORDS, AND THAT THE PLAT HEREON IS A CORRECT REPRESENTATION OF THE LOT LINES TO THE BEST OF MY KNOWLEDGE AND BELIEF.

Harold H. Kolb

HAROLD H. KOLB
WISCONSIN REGISTERED LAND SURVEYOR, S- 187

DATE April 5, 1979

ZWH-23

7-645K