HAROLD H. KOLB

REGISTERED PROFESSIONAL LAND SURVEYOR
LAKE GENEVA, WISCONSIN

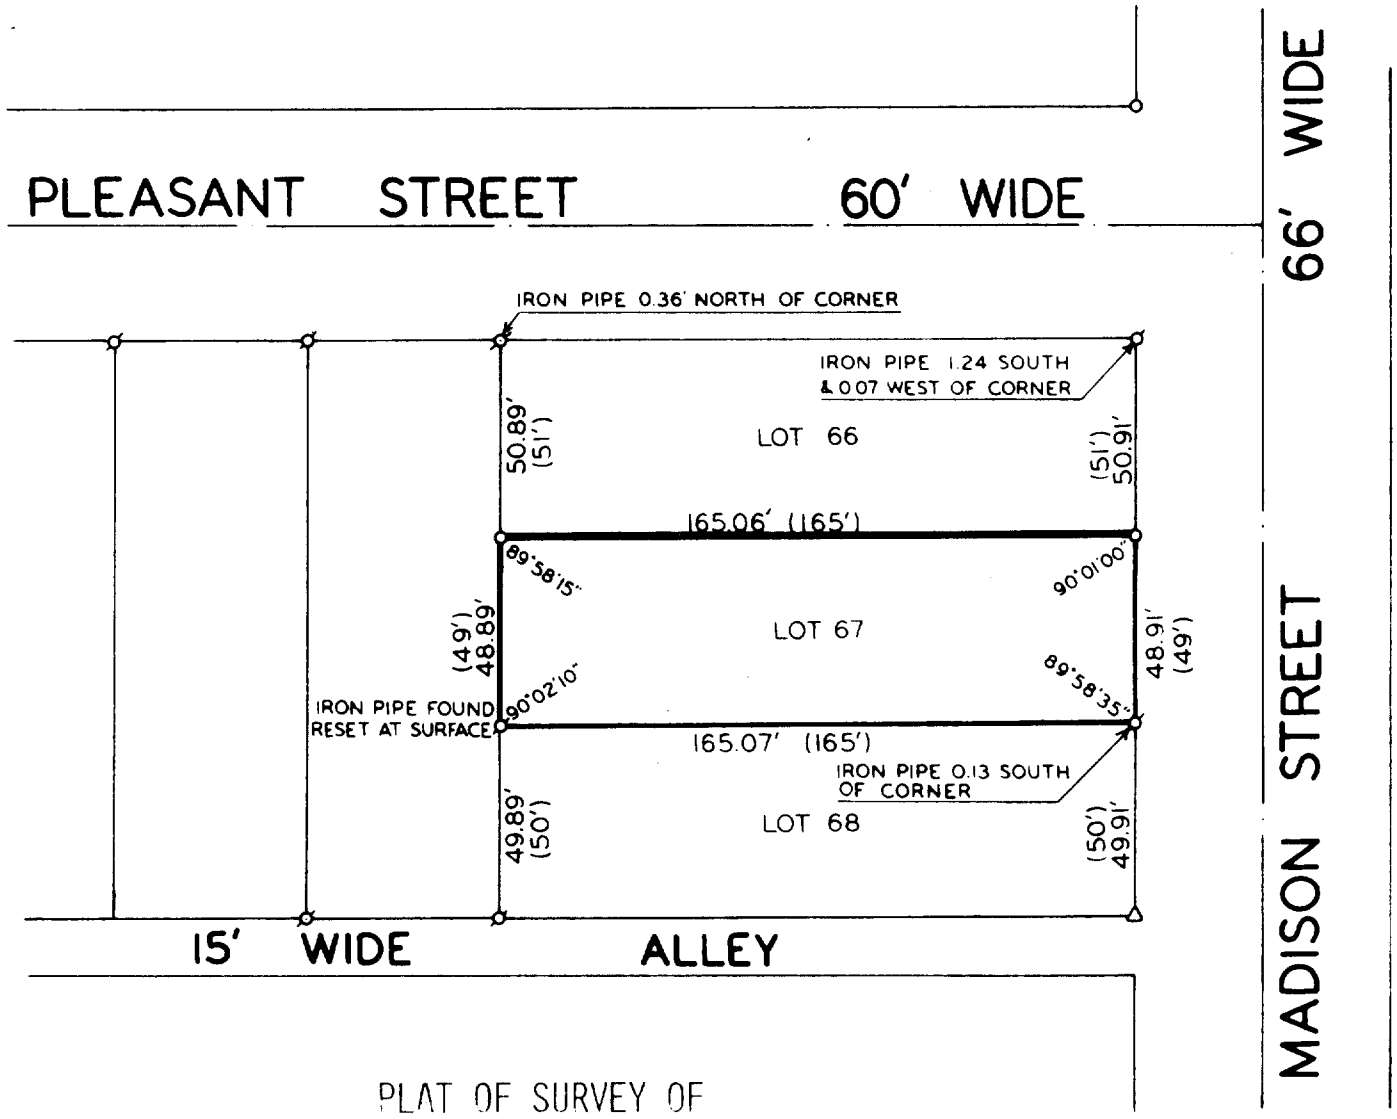

PLAT OF SURVEY OF

THE SOUTH 49 FEET OF LOT
67, COLUMBIAN SUBDIVISION,
CITY OF LAKE GENEVA,
WALWORTH COUNTY, WISCONSIN.

ORDERED BY: JIM O'BRIEN
LAKE GENEVA, WISCONSIN
53147

I, HAROLD H. KOLB, DO HEREBY CERTIFY THAT I HAVE SURVEYED THE PROPERTY HEREON DESCRIBED ACCORDING TO THE OFFICIAL RECORDS, AND THAT THE PLAT HEREON IS A CORRECT REPRESENTATION OF THE LOT LINES.

Harold H. Kolb

HAROLD H. KOLB
WISCONSIN REGISTERED LAND SURVEYOR, S-187
DATE Feb 17, 1978

N

SCALE: 1" = 50'

LEGEND

O — IRON PIPE PLACED. 1" x 24" 1.13 LB./LIN. FT.
● — CONCRETE MONUMENT. 5" DIA. x 30"
Δ — IRON ROD FOUND ø — IRON PIPE FOUND ( ) — AS PLATTED

BRUNING 40-105 1M-6-71

CL-57A

7-653K