
HAROLD H. KOLB

REGISTERED PROFESSIONAL LAND SURVEYOR
LAKE GENEVA, WISCONSIN

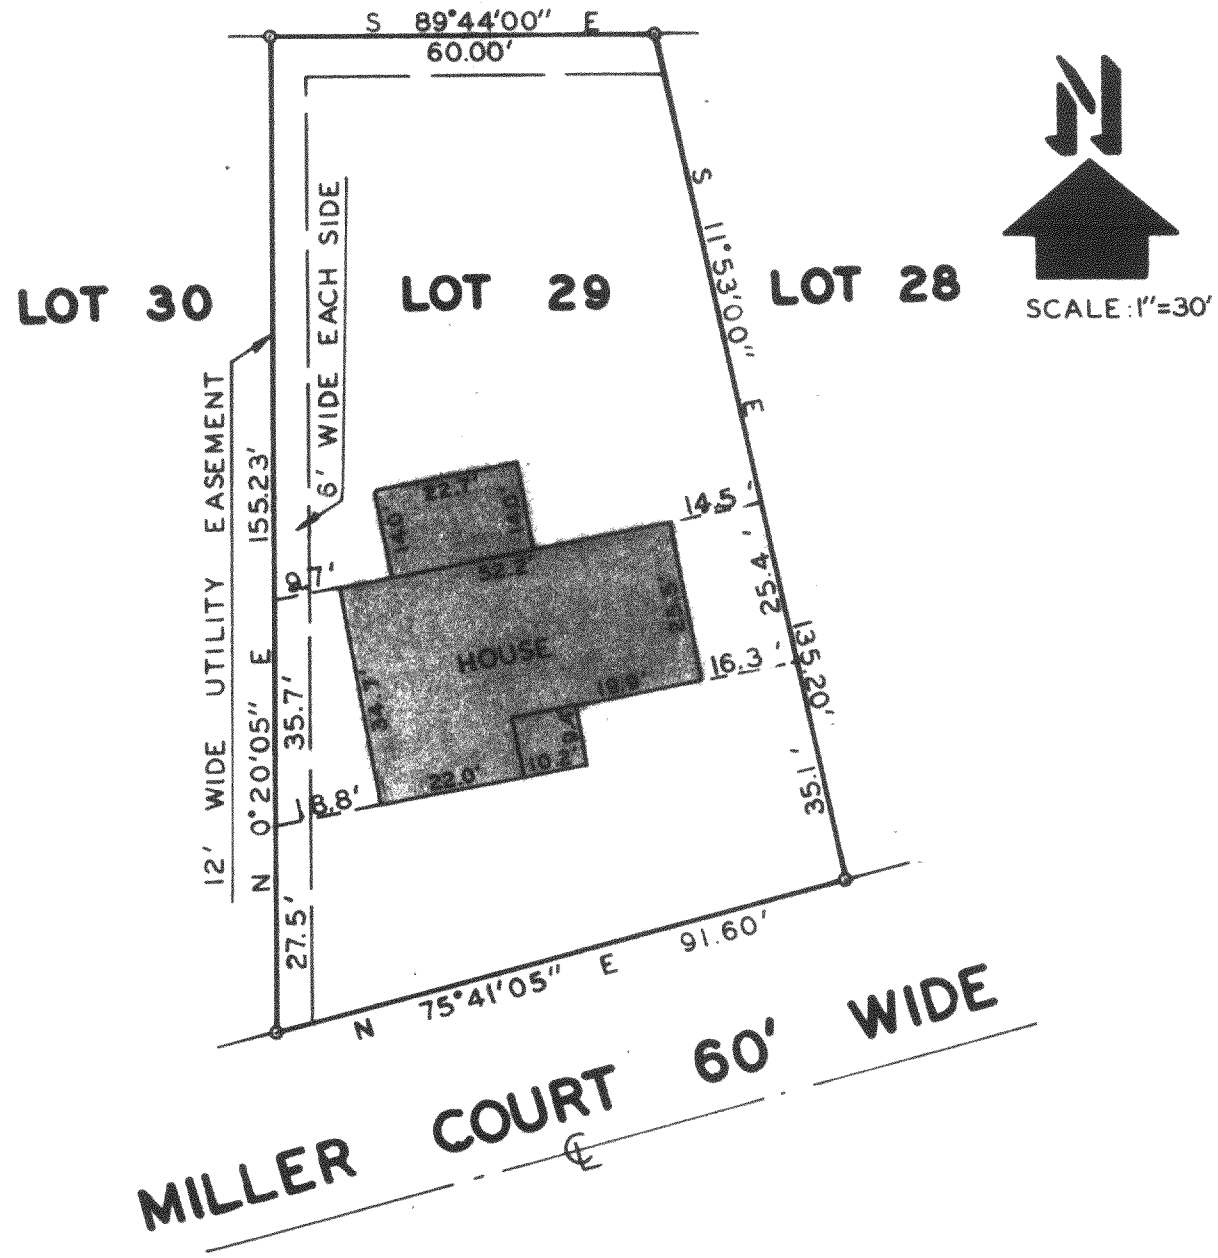

A PLAT OF SURVEY OF

LOT 29 OF WESTGATE SUBDIVISION, CITY OF LAKE GENEVA, WALWORTH COUNTY, STATE OF WISCONSIN.

ORDERED BY: VINCENT PUSATERI
1743 MILLER DRIVE
LAKE GENEVA, WI 53147

WISCONSIN HAROLD H. KOLB LAKE GENEVA, WIS. LAND SURVEYOR

I, HAROLD H. KOLB, DO HEREBY CERTIFY THAT I HAVE SURVEYED THE PROPERTY HEREON DESCRIBED ACCORDING TO THE OFFICIAL RECORDS AND THAT THE PLAT HEREON IS A CORRECT REPRESENTATION OF THE LOT LINES.

Harold H. Kolb

HAROLD H. KOLB
WISCONSIN REGISTERED LAND SURVEYOR, S-187
DATE Aug 29, 1978

REVISED: SEPTEMBER 20, 1978

LEGEND

O — IRON PIPE FOUND

BRUNING 40-105 1M-6-71

7-654K