
FARRIS, HANSEN & COOPER, INC.
ENGINEERING, SURVEYING AND LAND PLANNING
715 W WALWORTH ST. - P.O. BOX 487 - ELKHORN, WI 53121

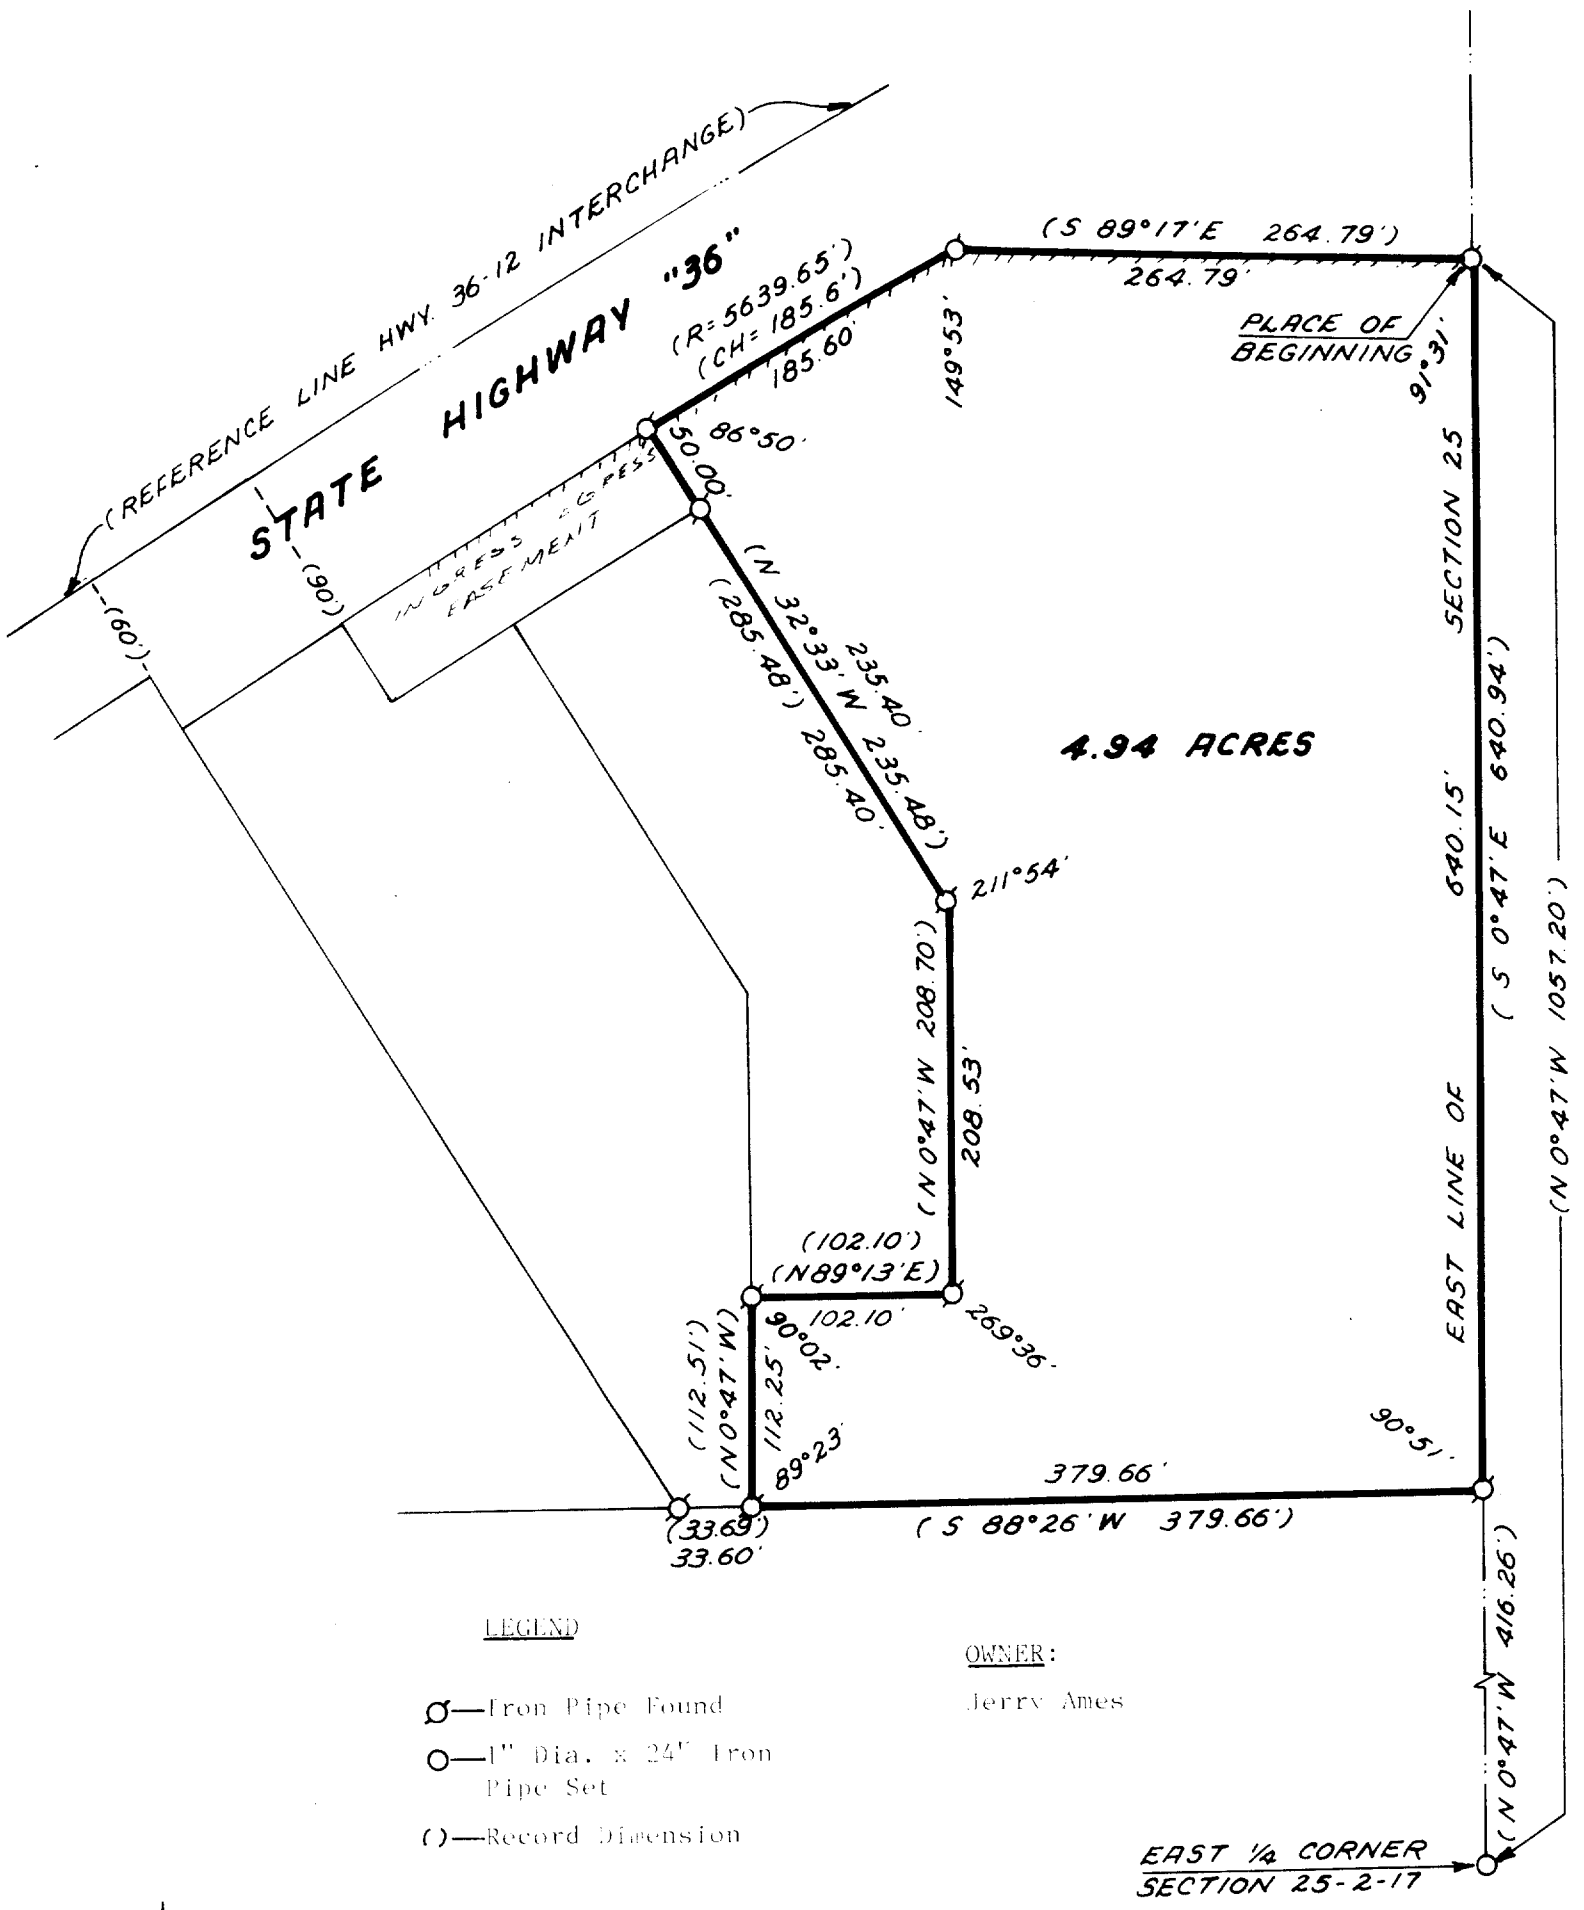

LEGEND

—Iron Pipe Found

—1" Dia. x 24" Iron Pipe Set

()—Record Dimension

OWNER:

Jerry Ames

PLAT OF SURVEY OF

DESCRIPTION OF RECORD:

A parcel of land located in the Northeast 1/4 of Section 25, T2N, R17E, City of Lake Geneva, Walworth County, Wisconsin, described as follows: Commencing at the East 1/4 Corner of said Section 25; Thence N 0°47' W 1057.20 feet along the East line of said Section 25 to the Southerly right-of-way line of State Trunk Highway "36" and the place of beginning; Thence S 0°47' E 640.94 feet along said East line; thence S 88°26' W 379.66 feet; thence N 0°47' W 112.51 feet; thence N 89°13' E 102.10 feet; thence N 0°47' W 208.70 feet; thence N 32°33' W 285.48 feet to the Southerly right-of-way line of State Trunk Highway "36"; thence Northeasterly along the arc of a curve to the right along said Southerly right-of-way line, the radius being 5639.65 feet and the chord 185.6 feet, to a point N 89°17' W 264.79 feet from the place of beginning, thence S 89°17' E 264.79 feet along said Southerly right-of-way line to the place of beginning. Containing 4.94 acres.

And easements appertainant thereto.

0 50 100
SCALE IN FEET
1"=100'

WISCONSIN
DANIEL D. COOPER
EAST TROY, WIS
LAND SURVEYOR

I HEREBY CERTIFY that I have surveyed the property described hereon and that this Plat of Survey is a true and accurate representation of the lot lines to the best of my professional knowledge and belief.

Daniel D. Cooper

Daniel D. Cooper, RLS No. 1464

Dated this 11th day of July, 1979.

PROJ. NO. 1556

~~UP-137C~~

7-676 F