#18-72

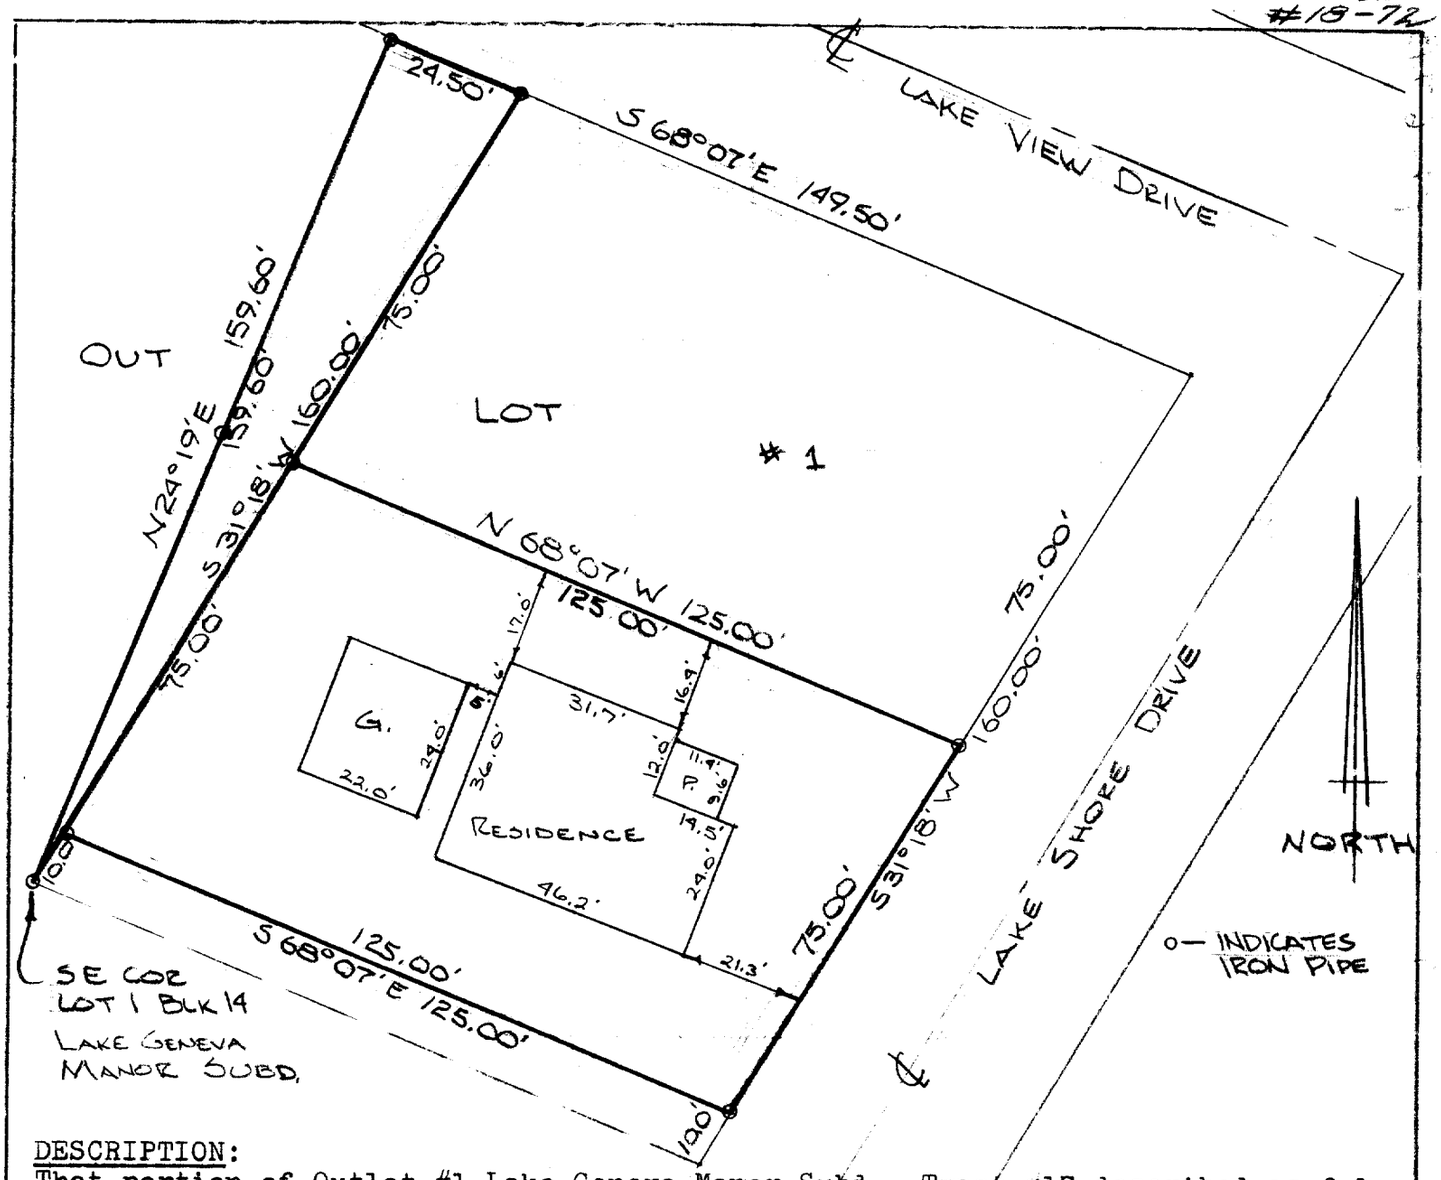

DESCRIPTION:
That portion of Outlot #1 Lake Geneva Manor Subd., Tract #17 described as follows, to-wit; Commencing at an iron stake in the S'ly line of said Outlot, 75.00 feet SW'ly from the SE'ly corner of said Outlot thence NW'ly parallel with the E'ly line of said Outlot 125.00 feet to an iron stake; thence SW'ly parallel with the S'ly line of said Outlot, 75.00 feet to an iron stake; thence SE'ly parallel with the E'ly line of said Outlot,125.00 feet to an iron stake in the S'ly line of said Outlot; thence NE'ly in the S'ly line of said Outlot, 75.00 feet to the place of beginning..Also, that portion of Outlot #1, above mentioned, described as follows, to-wit; Commencing at an iron stake on the SE corner of Lot 1, Block 14, Lake Geneva Manor Subd., hereinbefore described, thence N 24°19' E 159.60 feet to an iron stake in the NE'ly line of Lake View Drive; thence S 68°07' E 24.50 feet along said Lake View Drive to an iron stake; thence S 31°18' W 160.00 feet to the place of beginning.

CERTIFICATE:
I, hereby certify that the above survey was completed by the undersigned and that the land as shown and described hereon is a true representation of the parcel as staked at the site.

Signed and sealed
Joseph M. Biagi RLS #12
Elkhorn, Wisconsin.

January 18th 1972.

LM-~~89~~ and LM-89A

7-67B