
56-88

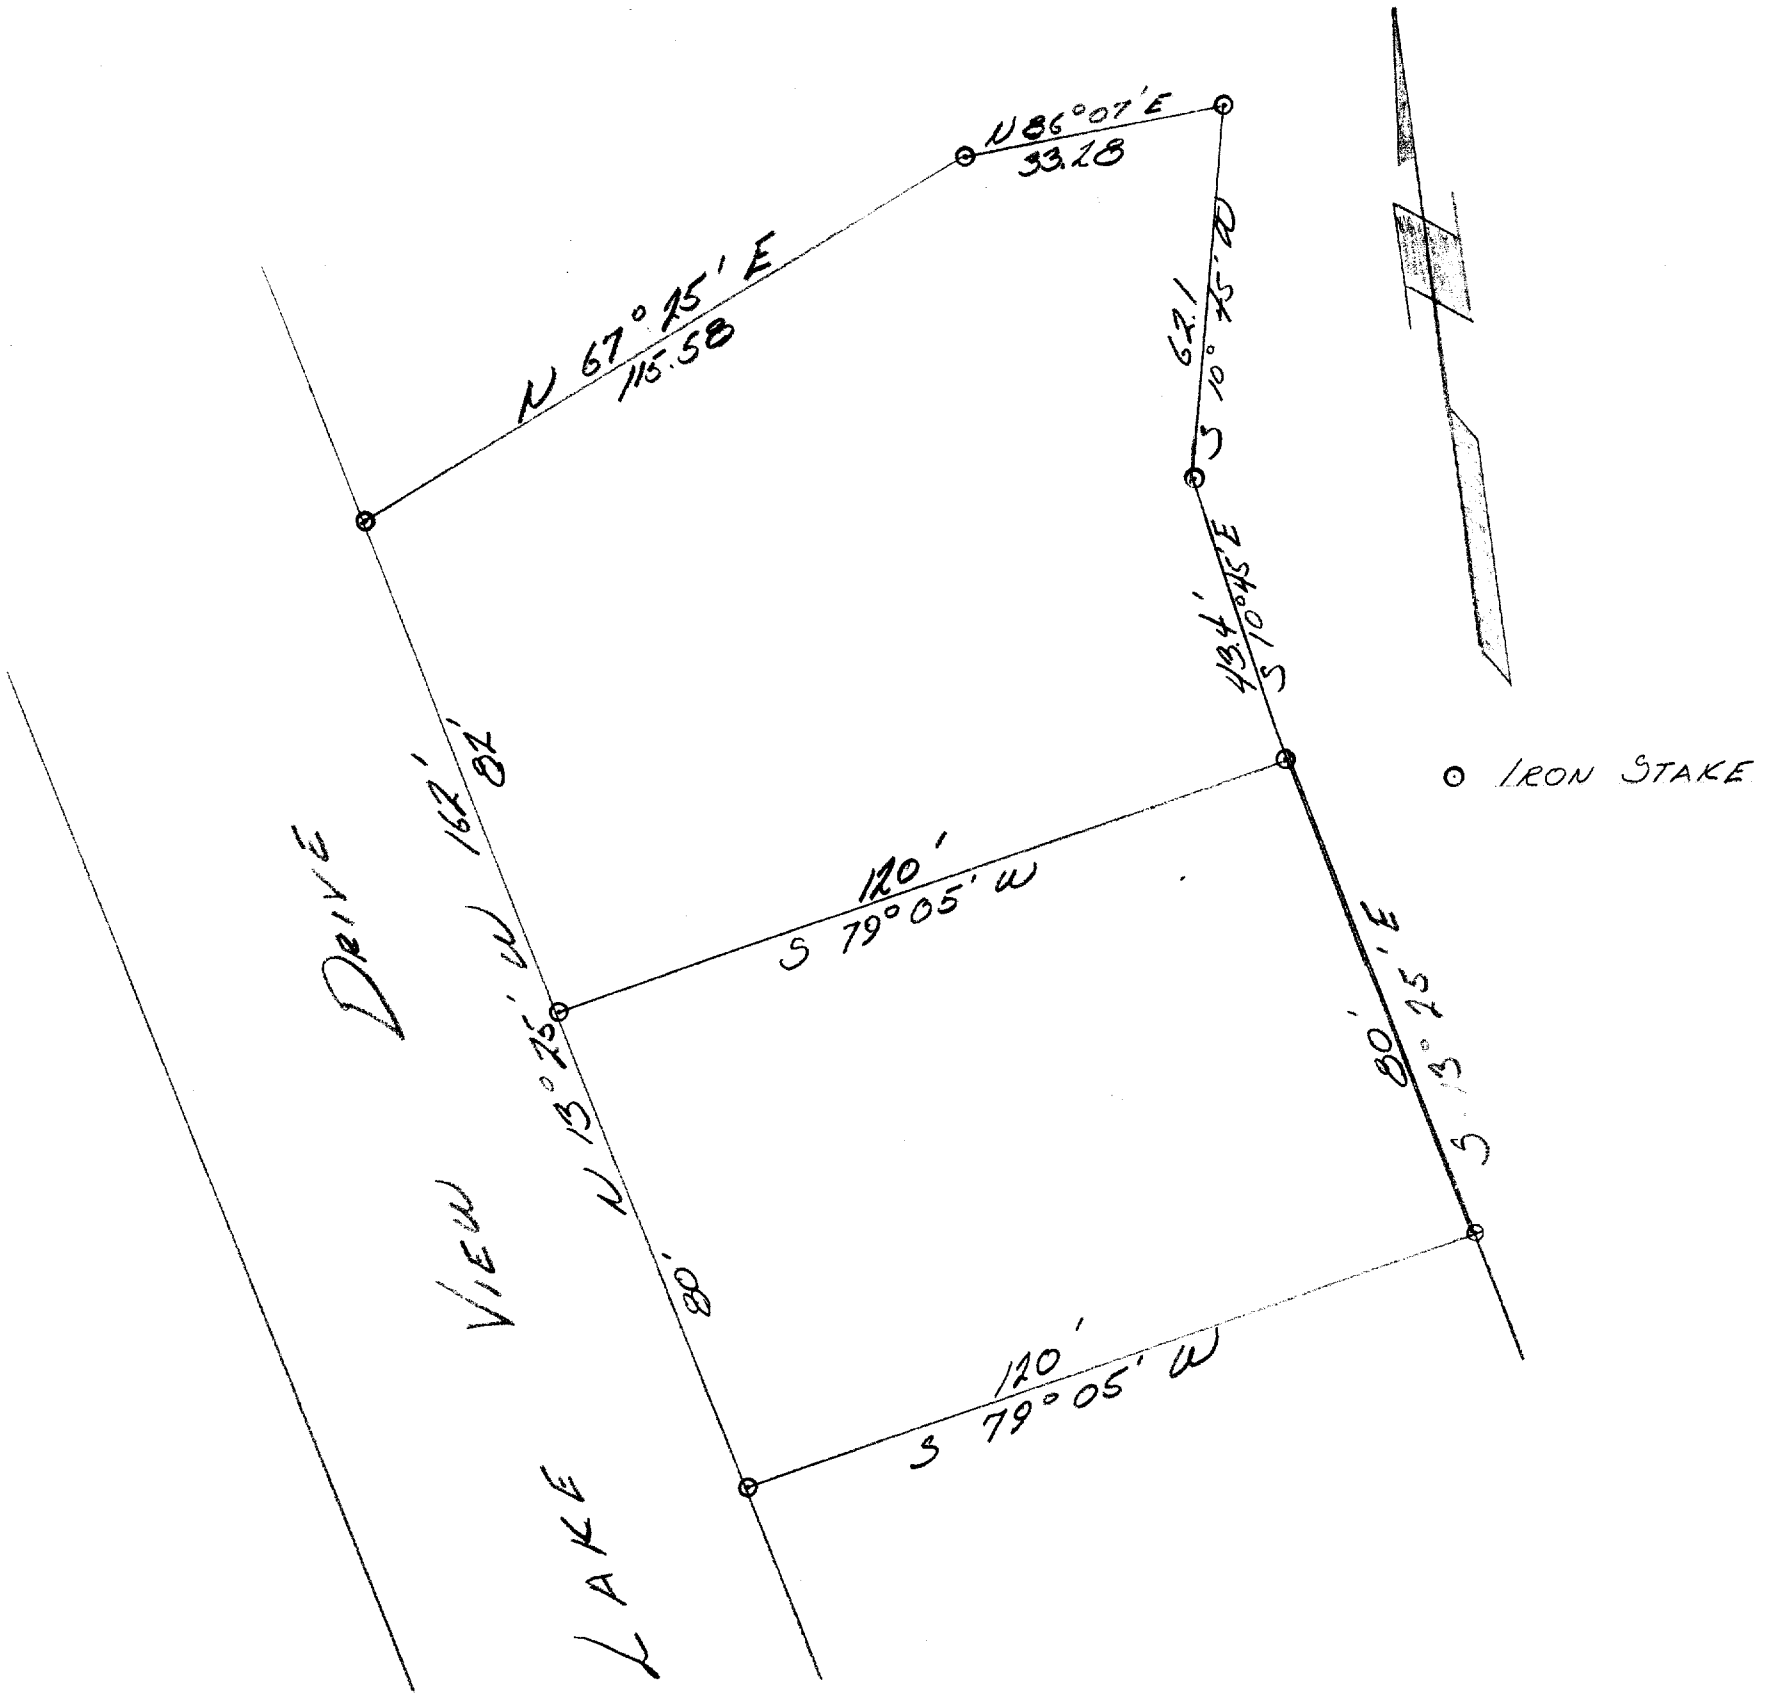

DESCRIPTION: Commencing at a point in the easterly line of Lake View Drive which is 40 feet Southeasterly from the Northwest corner of lot 16, Block 31 Lake Geneva Manor, City of Lake Geneva, Walworth County, Wisconsin; thence N. 13° - 25' W. 162 feet to an iron stake, thence N. 67° - 25' E. 115.58 feet to an iron stake, thence N. 86° - 07' E. 33.28 feet to an iron stake, thence S. 10° - 45' W. 62.1 feet to an iron stake, thence S. 10° - 45 ' E. 43.4 feet to an iron stake thence S. 13° - 25' E. 80.0 feet to an iron stake , thence S. 79° 05' W. 120.0 feet to the place of beginning.

CERTIFICATE: I hereby certify that I have on this the 24th day of February, 1956 surveyed the above described property and that the above drawing is an accurate deliniation of the survey.

SIGNED AND SEALED ON THIS THE 27TH DAY OF FEBRUARY, 1956.

James F. Biagi

James F. Biagi, Reg. Land Surveyor.
Elkhorn, Wisconsin.

7-68B

LM-75 (part 1)