PLAT OF SURVEY OF THE SOUTH 111.6 FEET OF THE WEST 43 FEET OF LOT 7, BLOCK 27, ORIGINAL PLAT, CITY OF LAKE GENEVA, WALWORTH COUNTY, WISCONSIN

FARRIS, HANSEN & COOPER, INC.

ENGINEERING, SURVEYING AND LAND PLANNING

715 W. WALWORTH ST. - P.O. BOX 487 - ELKHORN, WI 53121

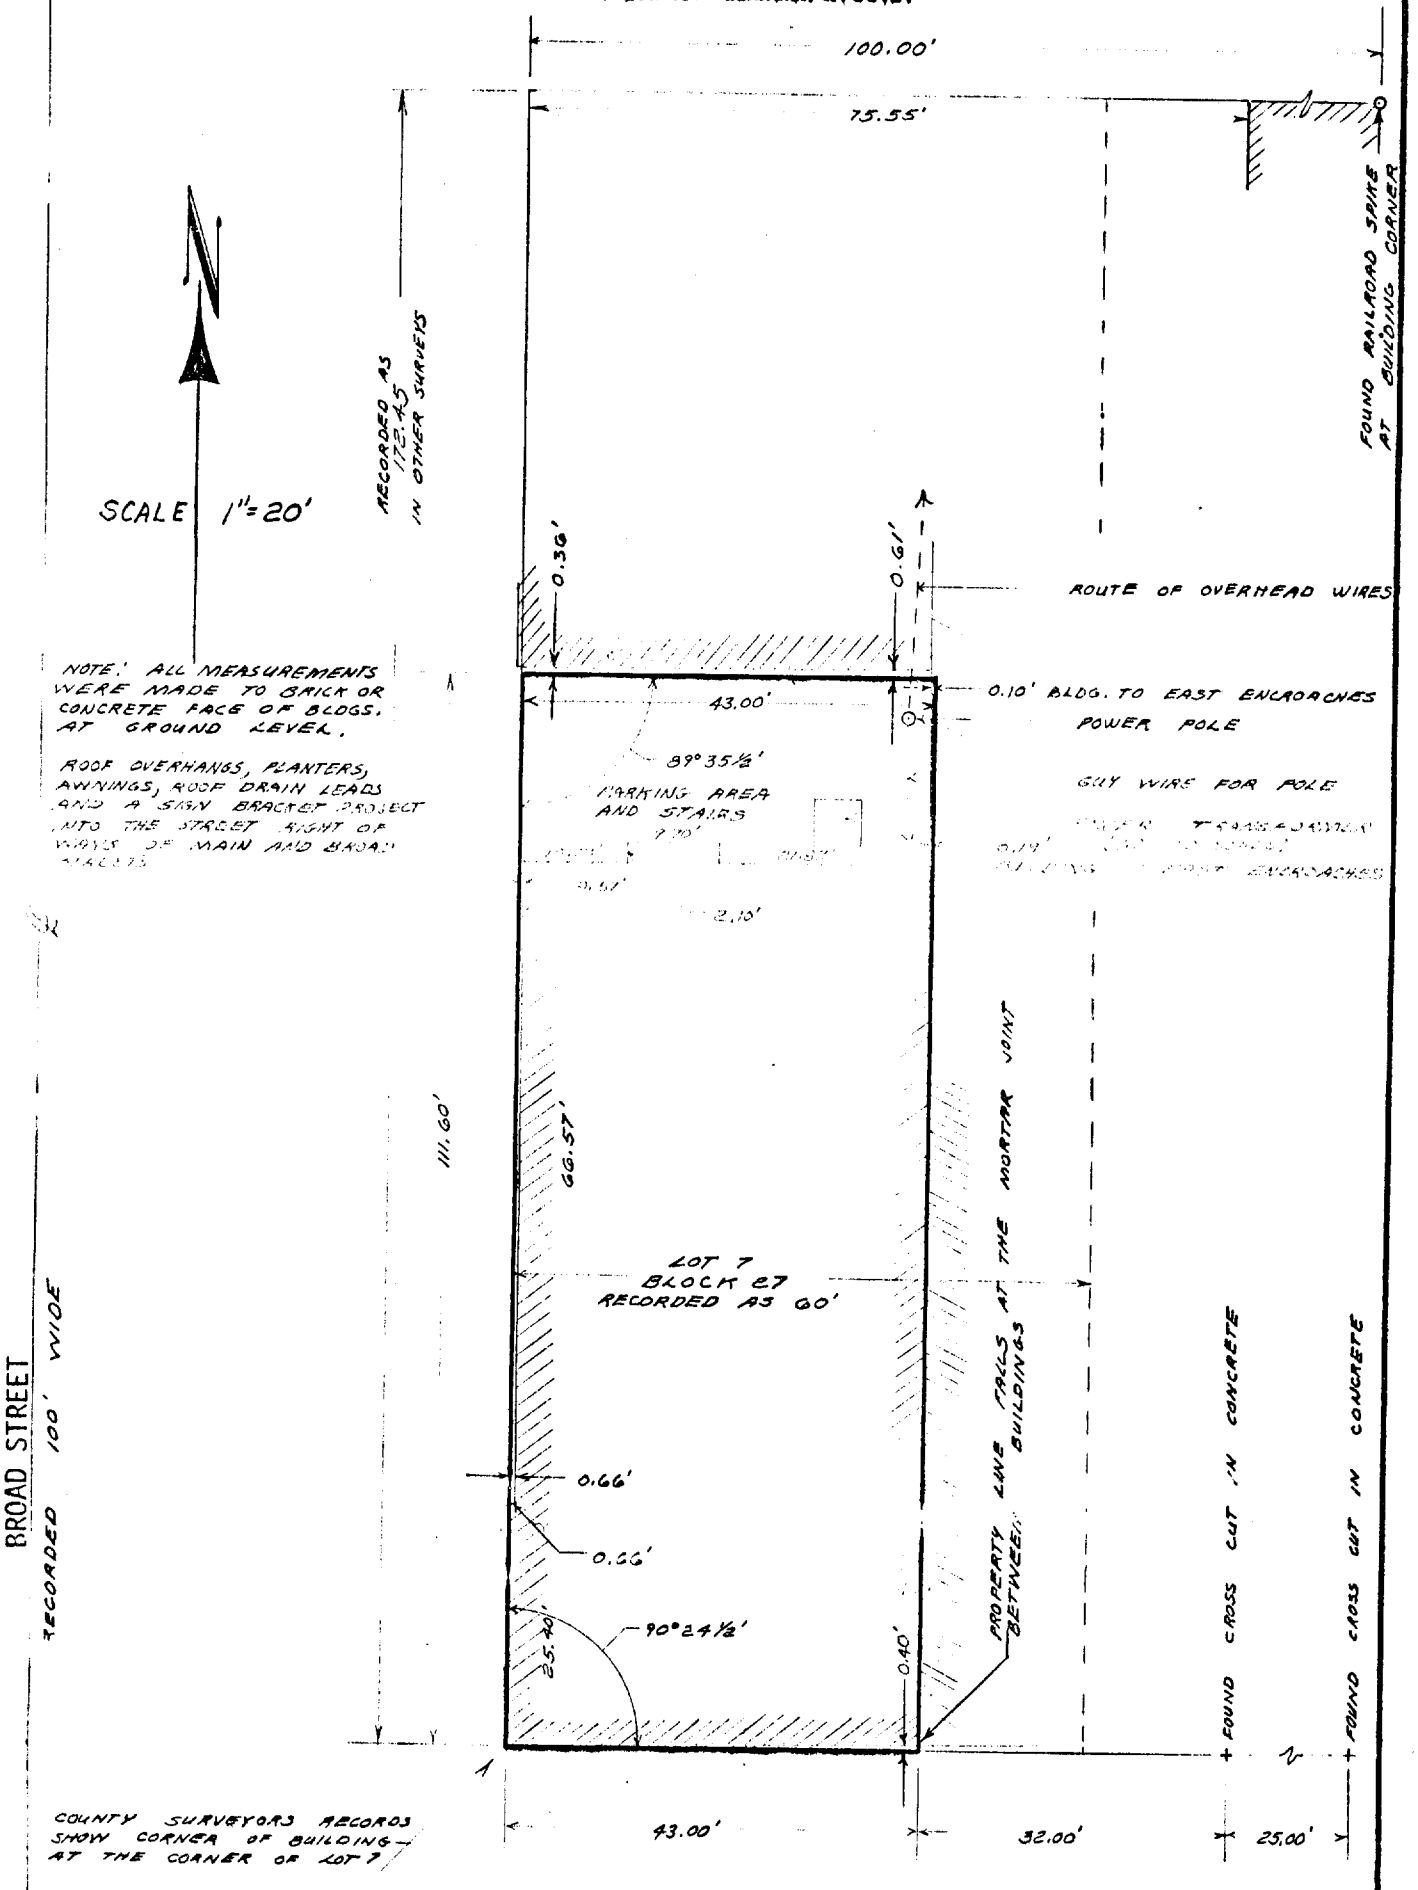

WISCONSIN
ROBERT A. FARRIS
S-1293
ELKHORN, WIS.
LAND SURVEYOR

I hereby certify that I have surveyed the above described property and that the above map is a true representation thereof and shows the size and location of the property, its exterior boundaries, the location of all visible structures and dimensions of all principal buildings thereon, boundary fences, apparent easements, roadways and visible encroachments, if any.

This survey is made for the use of the present owners of the property, and also those who purchase, mortgage, or guarantee the title thereto within one (1) year from date hereof.

Robert A. Farris
31 JAN 1980

JAN. 31, 1980

PROJECT NO. 1664

ZOP-267

7-694