FARRIS, HANSEN & COOPER, INC.
ENGINEERING, SURVEYING AND LAND PLANNING
715 W. WALWORTH ST. - P.O. BOX 487 - ELKHORN, WI 53121

PLAT OF SURVEY OF

Existing parcels in the Geneva Lake Crawford Manufacturing Company's Addition, Section 25, Town 2 North, Range 17 East, City of Lake Geneva, Walworth County, Wisconsin.

PARCEL A: The South 45 feet of Lot 11, Block 6, Geneva Lake Crawford Manufacturing Company Addition to the City of Lake Geneva, Walworth County, Wis.

PARCEL B: The North 15 feet of Lot 11, Block 6 and the South 30 feet of Lot 10, Block 6, Geneva Lake Crawford Manufacturing Company Addition to the City of Lake Geneva, Walworth County, Wisconsin.

ORDERED BY: Jane Freitag
Rich Port Realty

LEGEND

—Iron Pipe Found

()—Record Dimension


I HEREBY CERTIFY that I have surveyed the property described, as previously surveyed in 1949, and that this Plat of Survey is a true and accurate representation of the lot lines and buildings thereon to the best of my professional knowledge and belief.

WISCONSIN DANIEL D. COOPER S-1464 EAST TROY, WIS. LAND SURVEYOR

Daniel D Cooper

Daniel D. Cooper, RLS 1464
Date: May 30, 1979

0 5 10 20
SCALE IN FEET
1"=20'

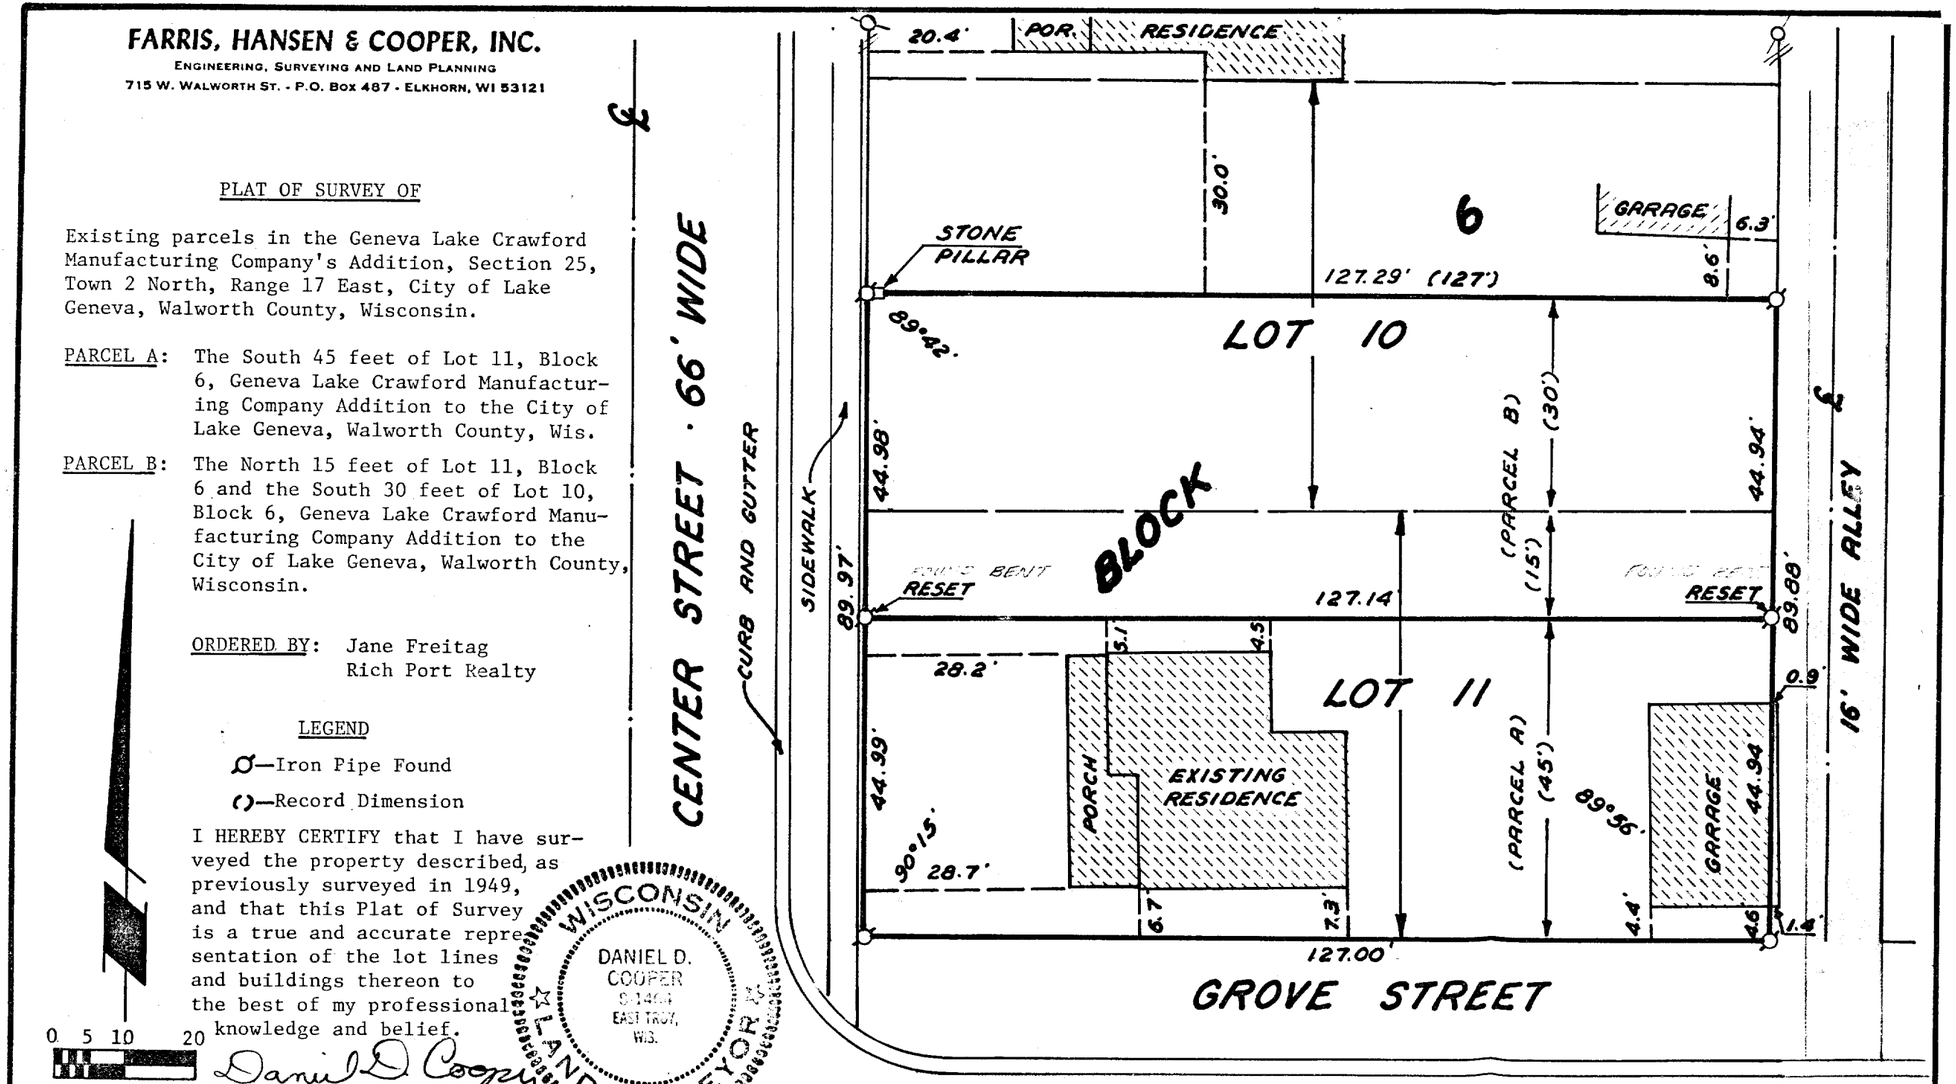

PROJECT NO. 1528

ZGC-17.17f

7-694F