
55-6

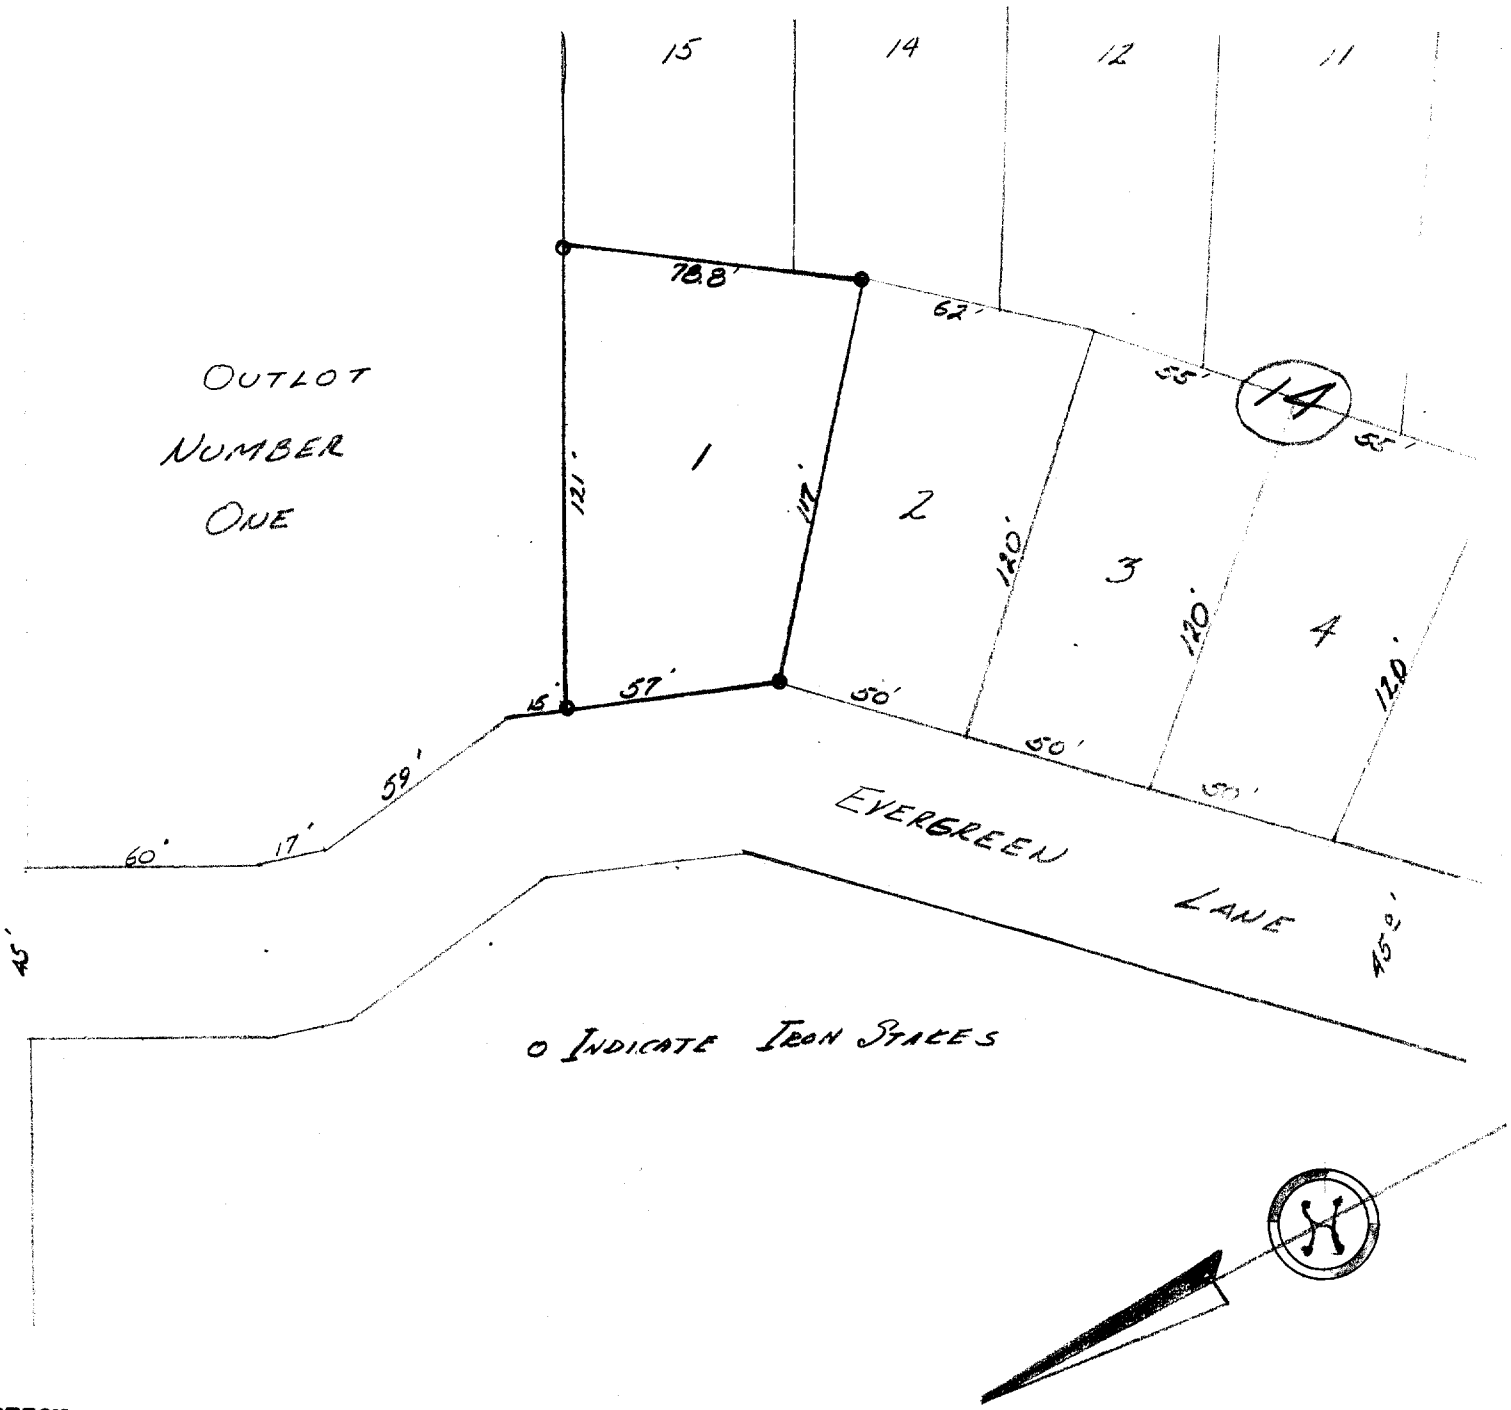

DESCRIPTION:

Lot 1, Block 14 Lake Geneva Manor Subdivision, of the City of Lake Geneva, Walworth County, Wisconsin.

CERTIFICATE:

I, hereby certify that I have on this the 5th day of March 1955, surveyed the above described and portrayed property, according to the official records on file in the office of the Recorder of Deeds in and for Walworth County, Wisconsin, and find that no encraochments exist.

SIGNED AND SEALED ON THIS THE 5 TH DAY OF MARCH 1955.

Joseph M. Biagi. Professional Engineer.
Elkhorn Wisconsin.

7-69B