
55-34

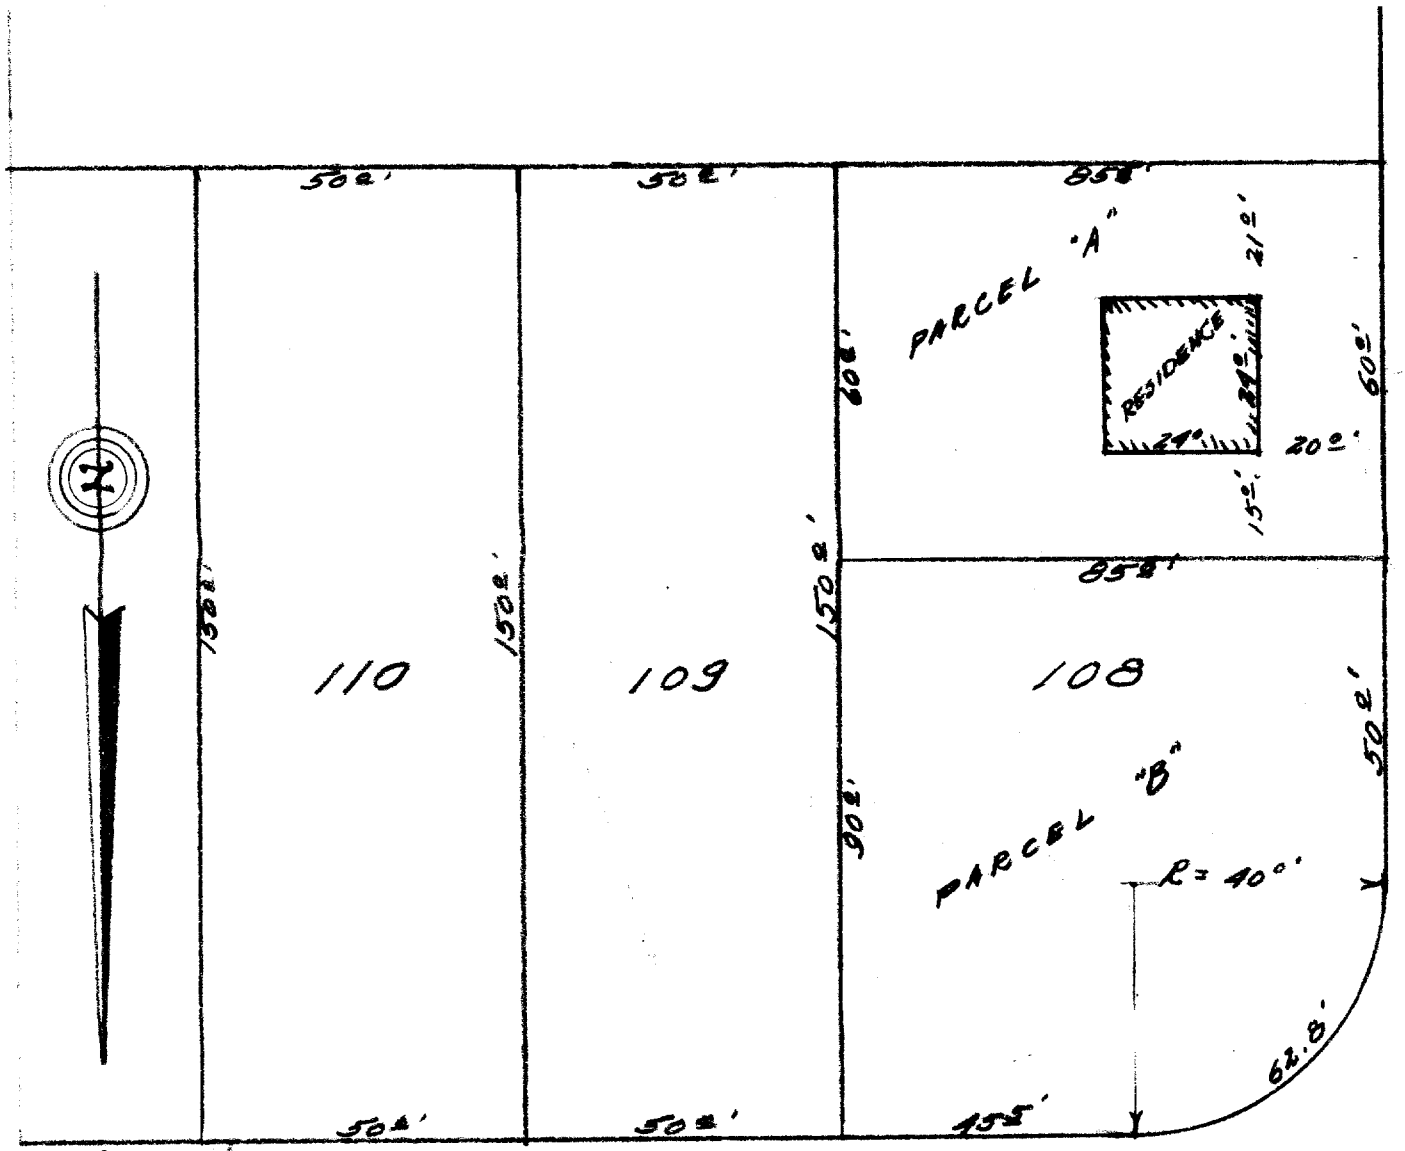

DESCRIPTION: Parcel "A". The south 60 feet of Lot 108 Columbian Subdivision, of a portion of the City of Lake Geneva, Walworth County, Wisconsin. Parcel "B". The north 90 feet of Lot 108 Columbian Subdivision of a portion of the City of Lake Geneva, Walworth County, Wisconsin.

CERTIFICATE: I, hereby certify that I have on this the 19th day of March 1955, surveyed the above described property, according to the official record on file in the office of the Recorder of Deeds in and for Walworth County, Wisconsin, and find that the measurements and bearings of the boundary lines of said property as taken at the site on this day substantially agree with those in said official record, and that the residence located on parcel "A" is in the position show on the plat hereon portrayed and that no encroachments exist.
SIGNED AND SEALED ON THIS THE 21ST DAY OF MARCH 1955.

Joseph M. Biagi. Professional Engineer.
Elkhorn Wisconsin.

CL-83

7-6B