
MAIN STREET

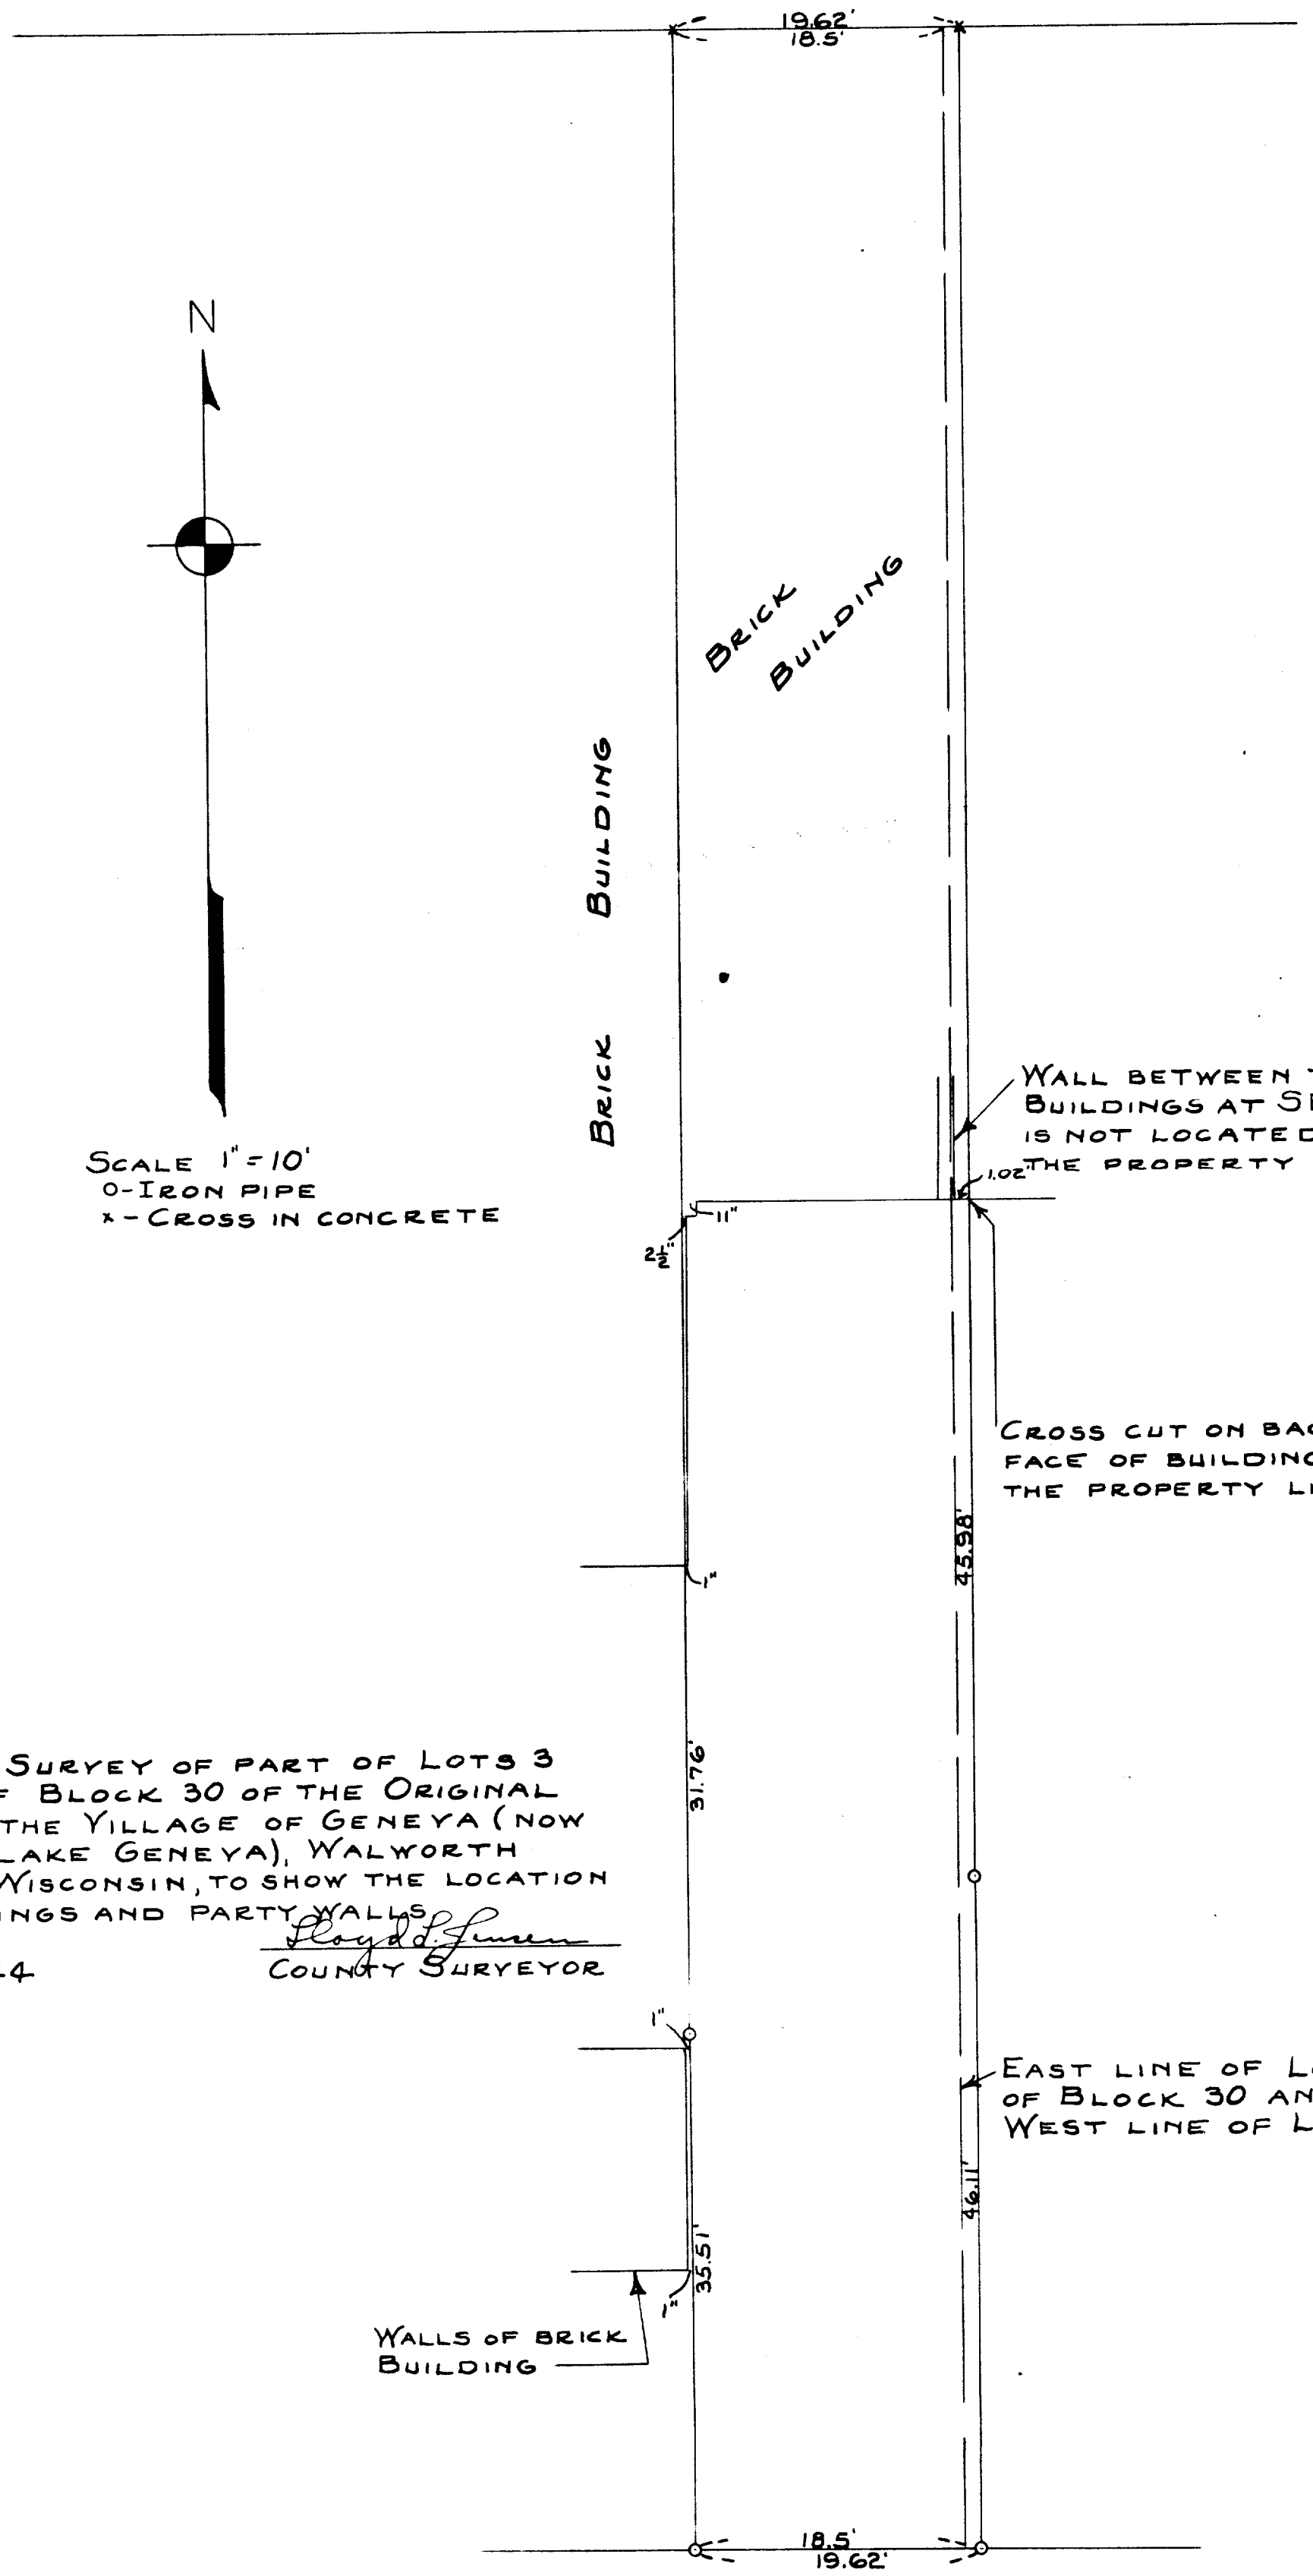

SCALE 1" = 10'
O-IRON PIPE
x-CROSS IN CONCRETE

PLAT OF SURVEY OF PART OF LOTS 3 AND 4 OF BLOCK 30 OF THE ORIGINAL PLAT OF THE VILLAGE OF GENEVA (NOW CITY OF LAKE GENEVA), WALWORTH COUNTY WISCONSIN, TO SHOW THE LOCATION OF BUILDINGS AND PARTY WALLS

SEPT. 1944

Floyd L. Simon
COUNTY SURVEYOR

PUBLIC ALLEY

16 FEET WIDE

OP-316

7-6J