
8-92

FARRIS, HANSEN & COOPER, INC.
ENGINEERING, SURVEYING AND LAND PLANNING
715 W. WALWORTH ST. - P.O. BOX 487 - ELKHORN, WI 53121
OFFICE: 414/723-2098

ORDERED BY: ZINZOW CONSTRUCTION CO.

OWNER: JAMES BEARDER

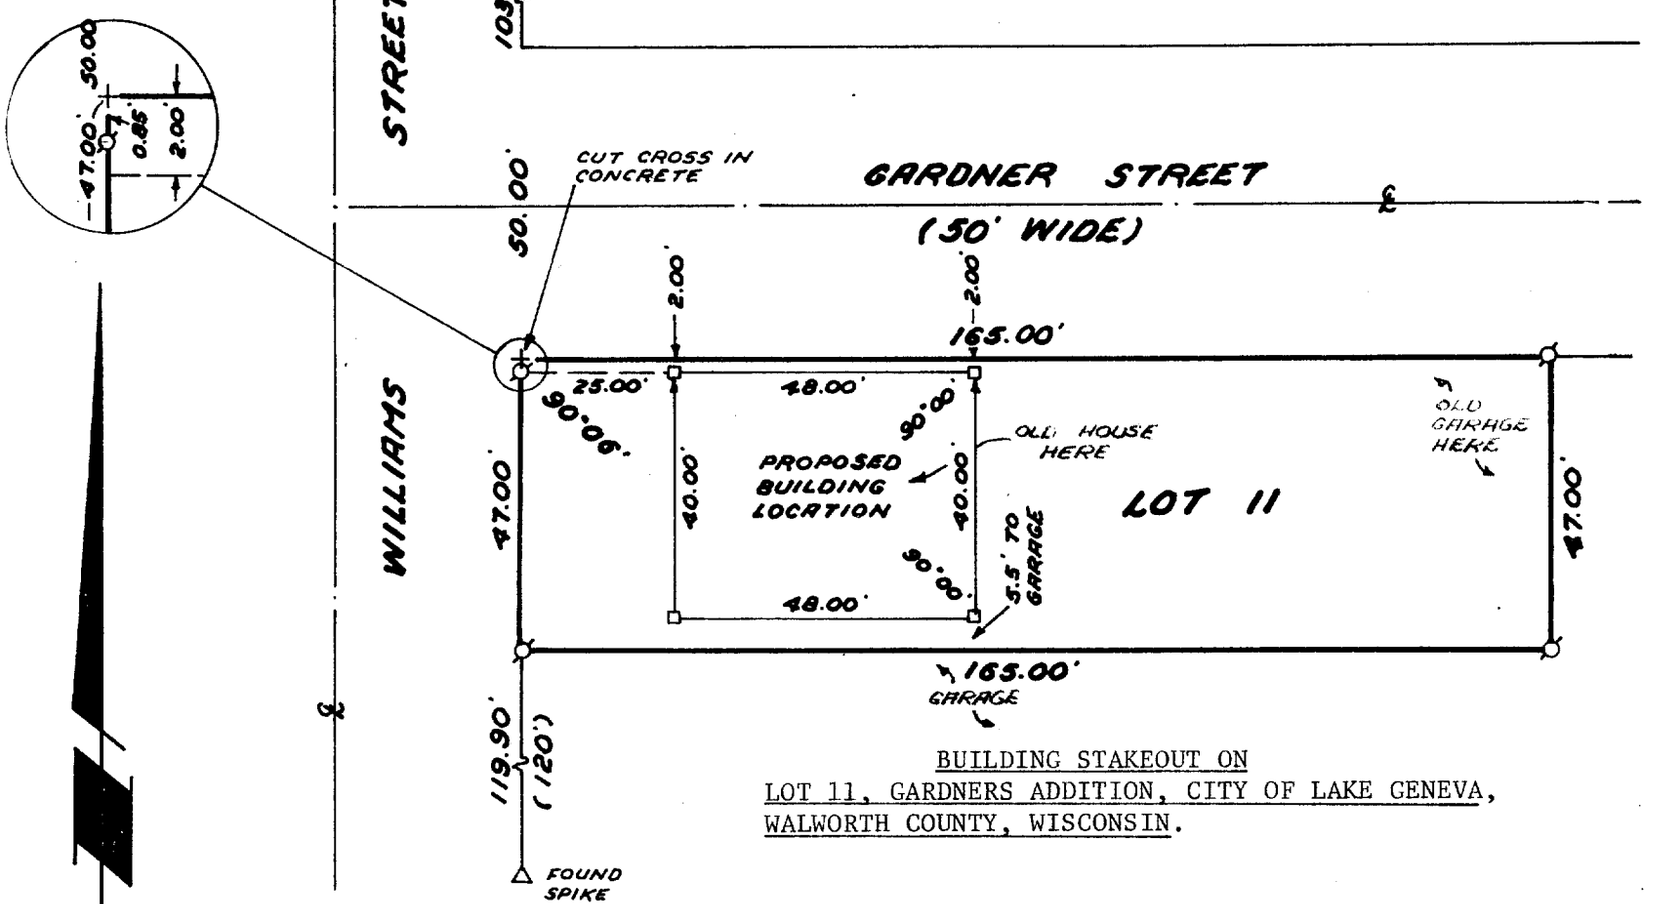

BUILDING STAKEOUT ON
LOT 11, GARDNERS ADDITION, CITY OF LAKE GENEVA,
WALWORTH COUNTY, WISCONSIN.

0 10 20 30
SCALE IN FEET
1"=30'

LEGEND

- ⌀—Iron Pipe Survey Stake Found
- □—Wooden Stake Set
- ( )—Record Dimension

NOTE: BUILDING STAKED ACCORDING TO BUILDER'S INSTRUCTIONS-WE MAKE NO REPRESENTATION AS TO BUILDING LOCATION APPLYING TO APPLICABLE ZONING ORDINANCES.

Dated this 5th day of August 1980.

WISCONSIN
ROBERT A. FARRIS
S-1293
ELKHORN, WIS.
LAND SURVEYOR

I HEREBY CERTIFY that I have surveyed the property described hereon and that this Plat is a true and accurate representation of the lot lines, and the proposed building location thereon, to the best of my professional knowledge and belief.

Robert A. Farris

Robert A. Farris, RLS

DRAWING NUMBER 1734

7-700F