
KOLB LAND CONSULTING, INC.

LAND SURVEYING · SUBDIVIDING · LAND PLANNING

LAKE GENEVA, WISCONSIN 53147 WHITEWATER, WISCONSIN 53190

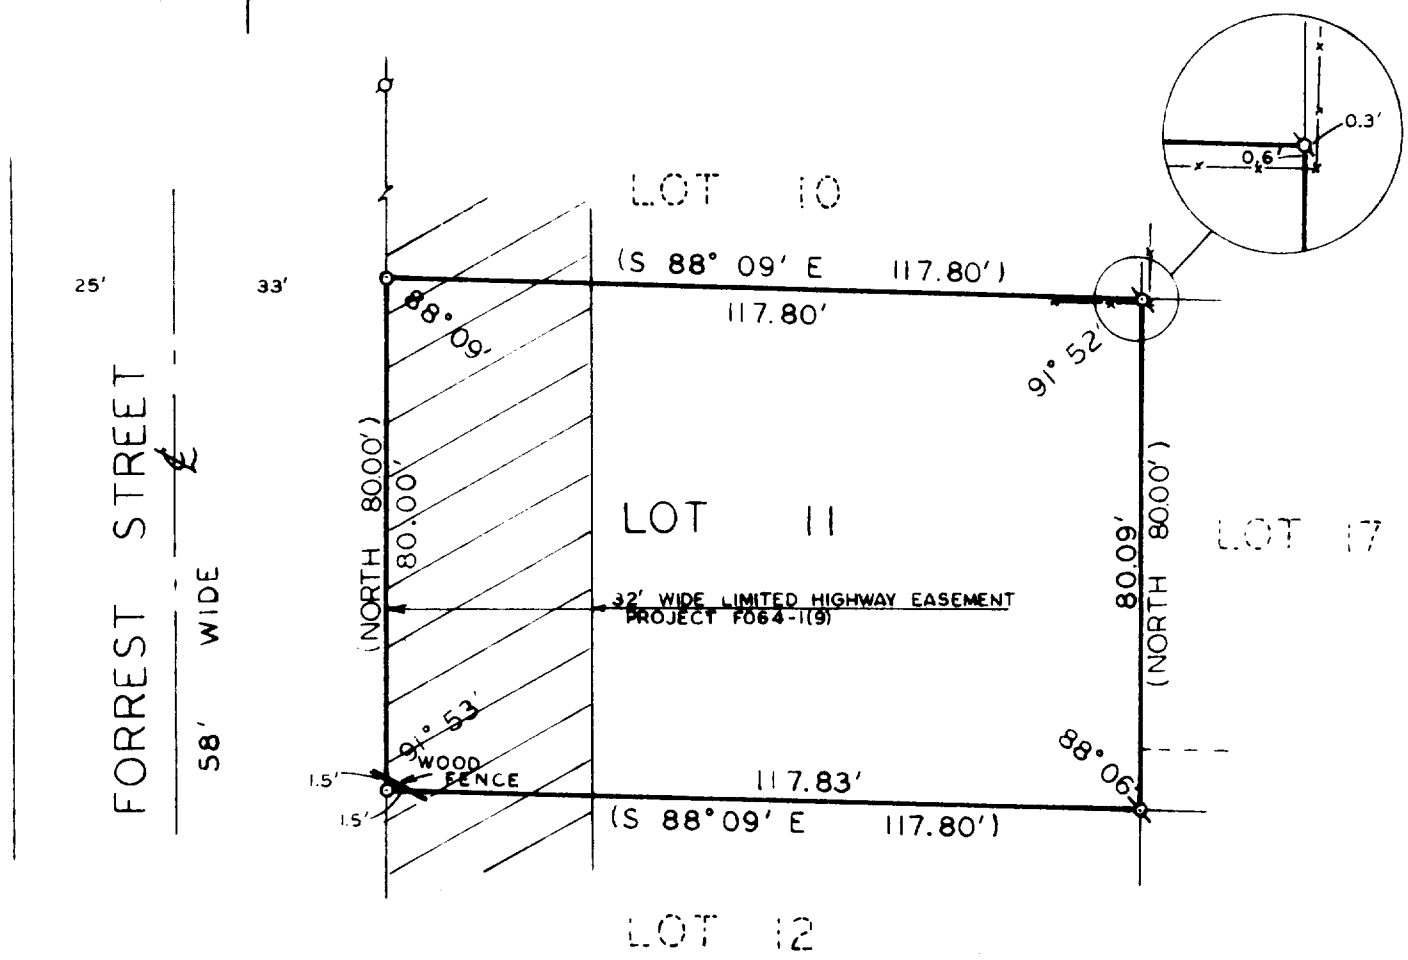

PLAT OF SURVEY OF

LOT 11, PEARSON SUBDIVISION LOCATED IN SECTION 35, T2N,R17E, CITY OF LAKE GENEVA, WALWORTH COUNTY, WISCONSIN.

ORDERED BY: WURTZ CONSTRUCTION, INC.
100 EAST MAIN STREET
LAKE GENEVA, WISCONSIN. 53147

N

SCALE: 1"= 30'

I, HAROLD H. KOLB, DO HEREBY CERTIFY THAT I HAVE SURVEYED THE PROPERTY HEREON DESCRIBED ACCORDING TO THE OFFICIAL RECORDS, AND THAT THE PLAT HEREON IS A CORRECT REPRESENTATION OF THE LOT LINES TO THE BEST OF MY KNOWDGE AND BELIEF.

LEGEND

o - IRON PIPE SET
o - IRON PIPE FOUND
—x— FENCE LINE
( ) - RECORDED AS

Harold H. Kolb

HAROLD H. KOLB
WISCONSIN REGISTERED LAND SURVEYOR, S- 187

DATE Dec 5, 1980

ZP-11

7-701-K