FARRIS, HANSEN & COOPER, INC.

ENGINEERING, SURVEYING AND LAND PLANNING


715 W. WALWORTH ST. - P.O. BOX 487 - ELKHORN, WI 53121

OFFICE: 414/723-2098

WORK ORDERED BY: ADAM ADAMS
ALVIN OLSEN
BOB ANDERSON

PLAT OF SURVEY LOT 34 OF BOULEVARD SUBDIVISION CITY OF LAKE GENEVA, WALWORTH COUNTY, WIS.

MAP SCALE 1" = 30'

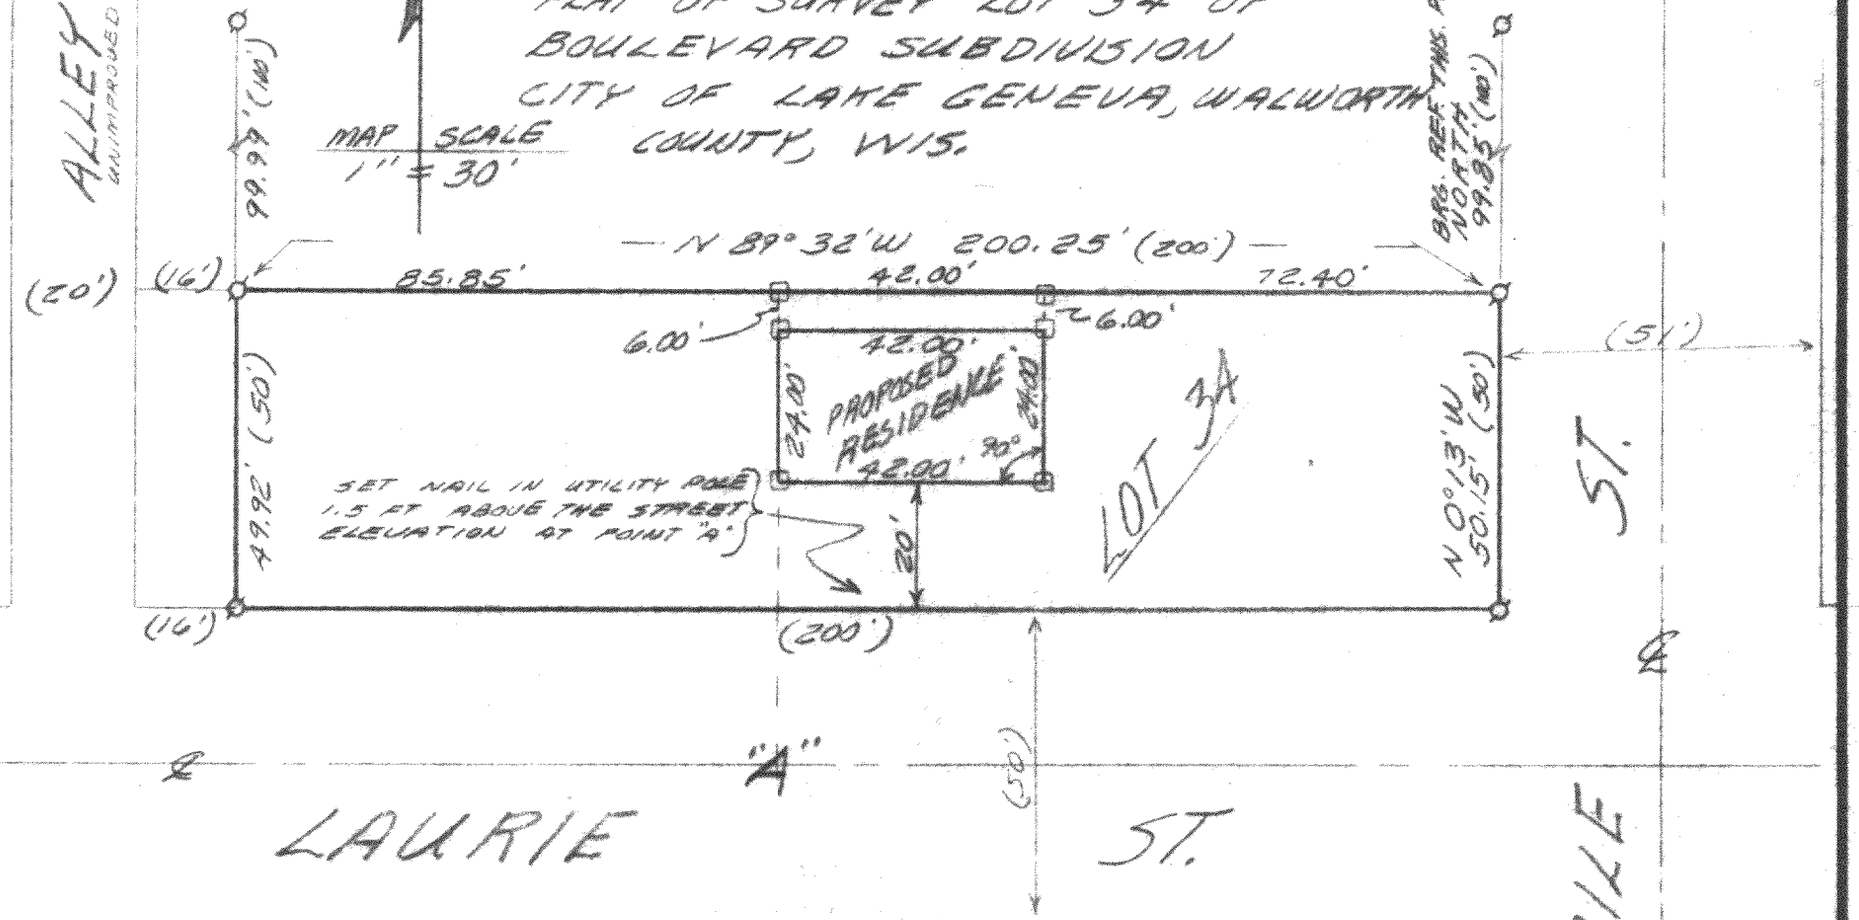

I hereby certify that this Plat of Survey is a true and accurate representation of the lot lines and of the stakes set for proposed residence to the best of my professional knowledge and belief.

Robert A. Farris
20 MARCH 1983

WISCONSIN
ROBERT A. FARRIS
S-1293
ELKHORN, WIS
LAND SURVEYOR

Ø = IRON PIPE SURVEY STAKE FOUND
□ = WOOD STAKE SET
(xxx) = RECORD DIMENSION

DRAWING NUMBER 2071

ZBL-27