
FARRIS, HANSEN & COOPER, INC.
ENGINEERING, SURVEYING AND LAND PLANNING
715 W. WALWORTH ST. - P.O. BOX 487 - ELKHORN, WI 53121
OFFICE: 414/723-2098

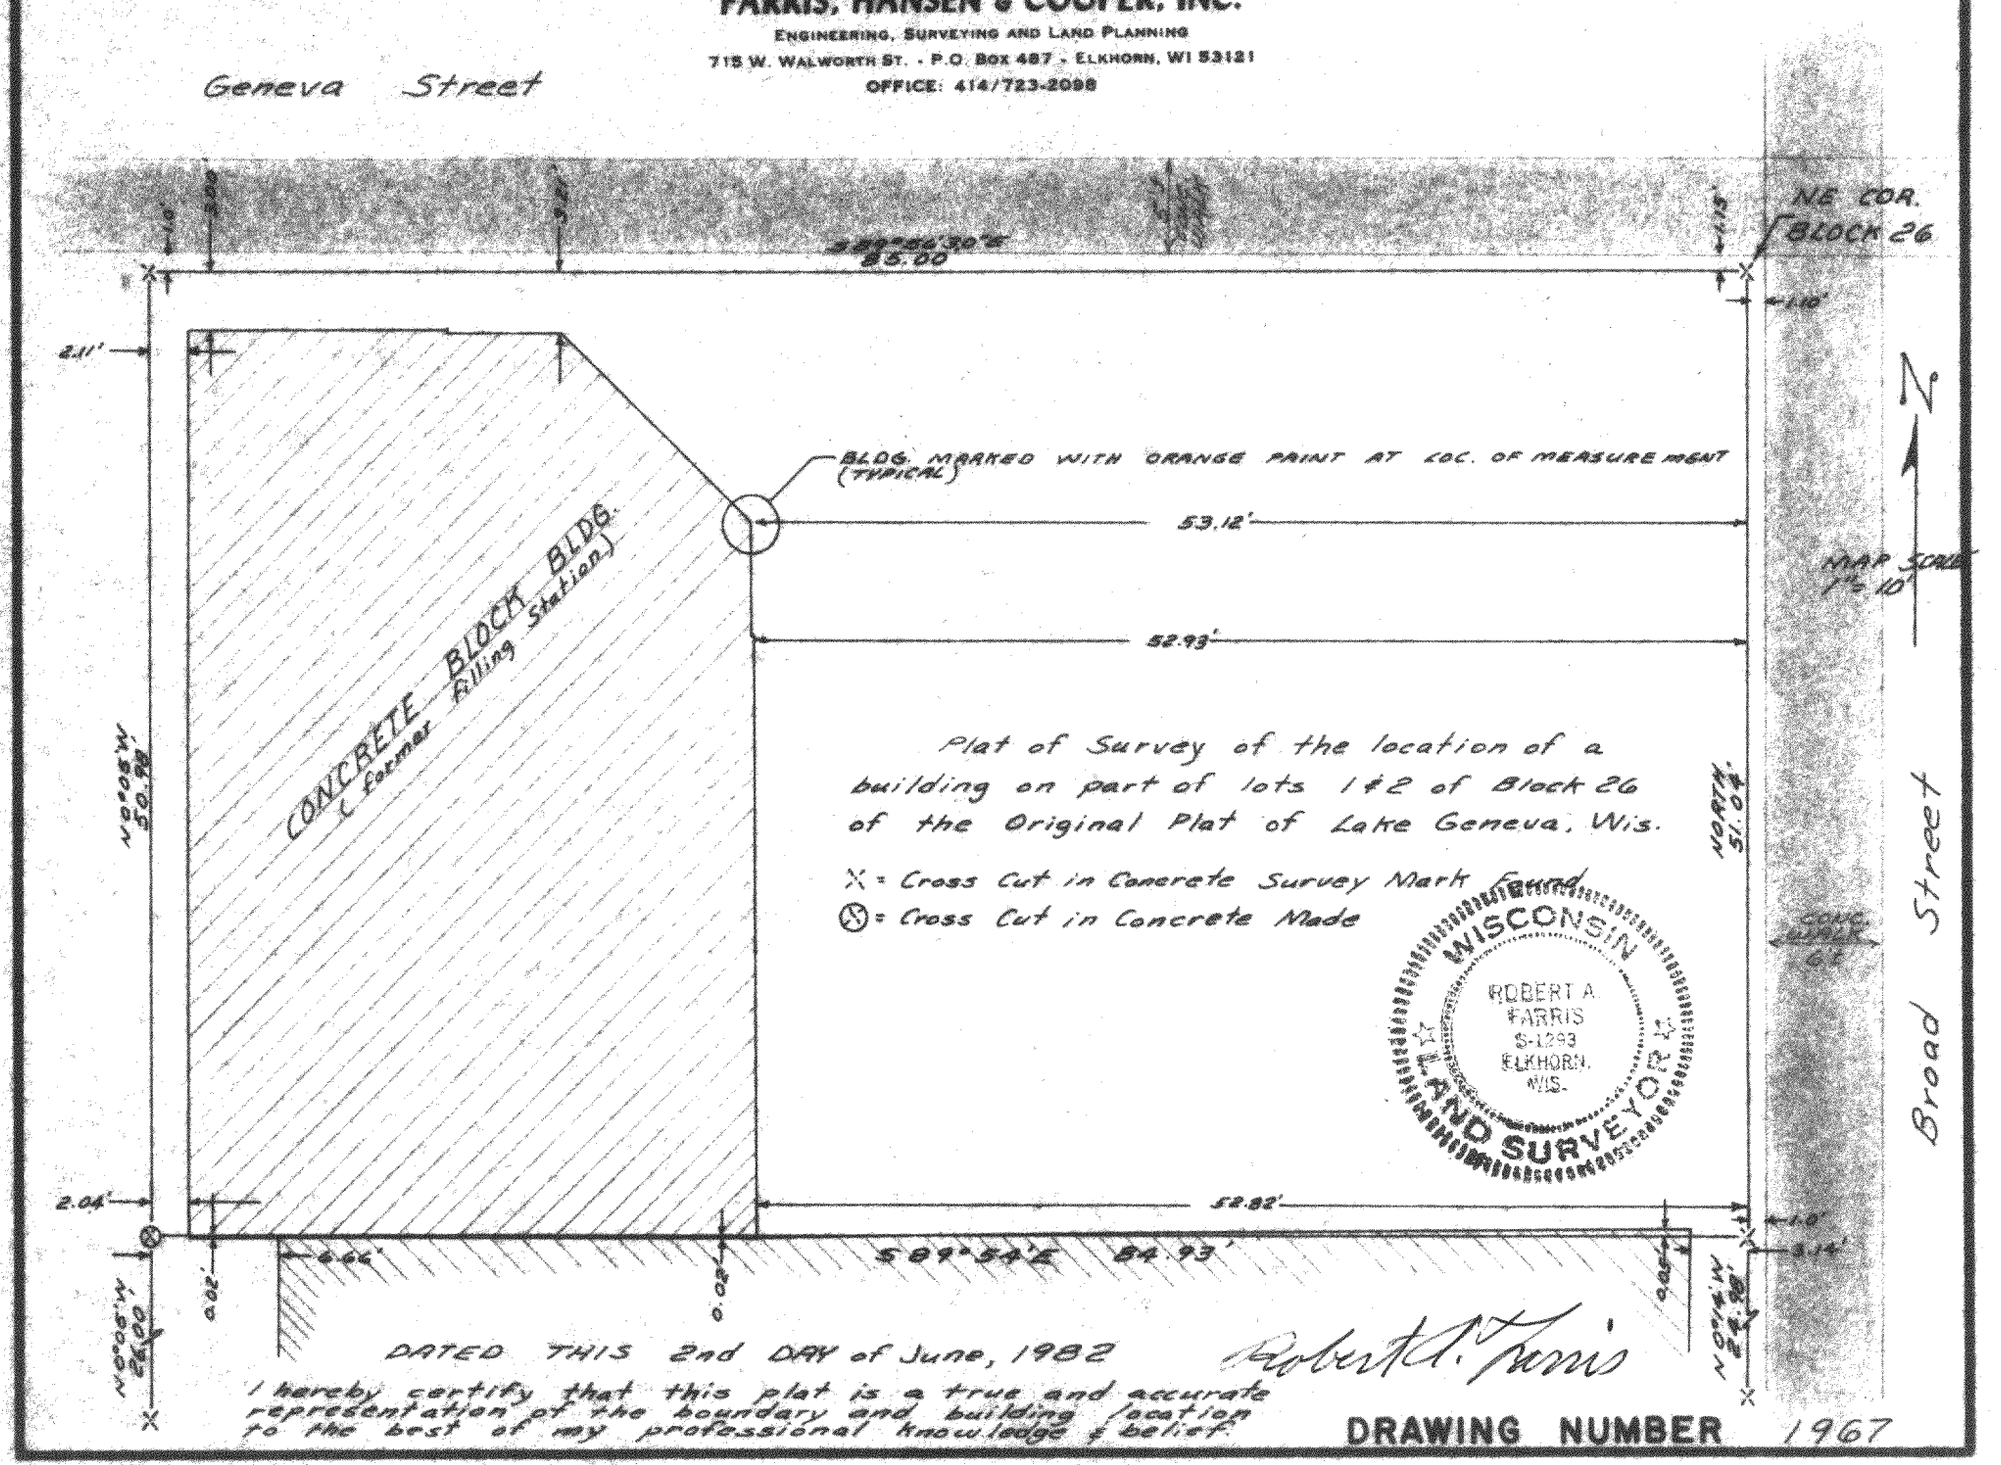

DATED THIS 2nd DAY of June, 1982

Robert A. Farris

I hereby certify that this plat is a true and accurate representation of the boundary and building location to the best of my professional knowledge & belief.

DRAWING NUMBER 1967

OP-244

7-705-F