
KOLB LAND CONSULTING, INC.

LAND SURVEYING · SUBDIVIDING · LAND PLANNING

LAKE GENEVA, WISCONSIN 53147 WHITEWATER, WISCONSIN 53190

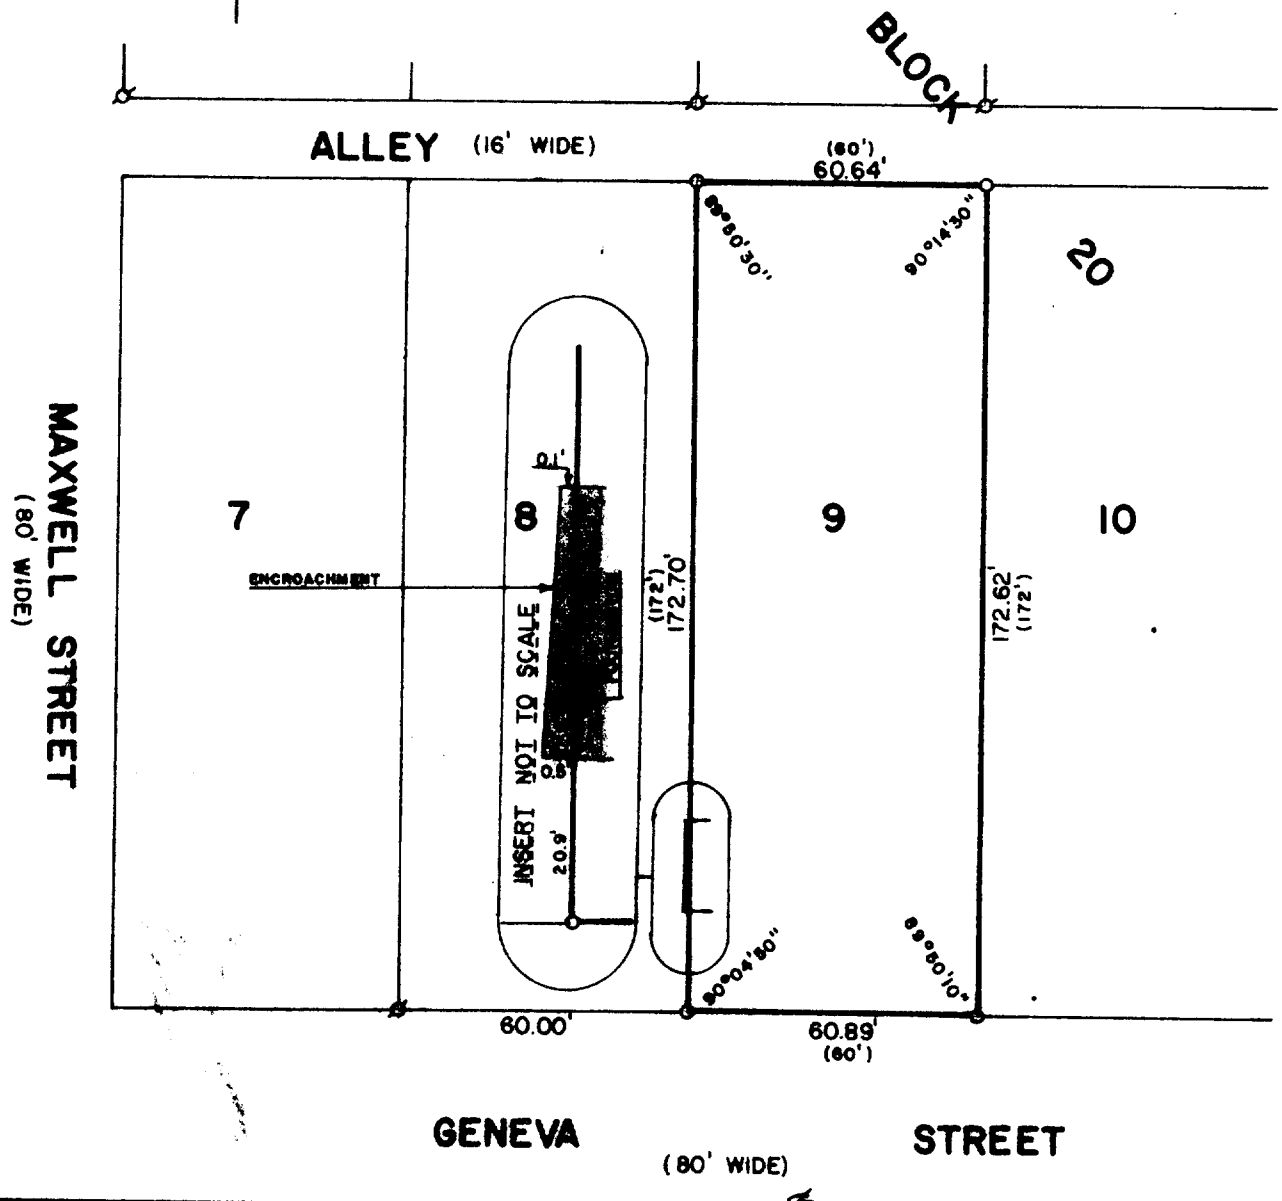

PLAT OF SURVEY OF

LOT 9, BLOCK 20, ORIGINAL PLAT OF THE CITY OF LAKE GENEVA, WALWORTH COUNTY, WISCONSIN.

ORDERED BY: JAMES TRUELSEN
1123 GENEVA STREET
LAKE GENEVA, WISCONSIN 53147

NOTE: THE ROOF LINE IS 1.2 FEET WEST OF THE FOUNDATION AS SHOWN IN THE INSERT.

WISCONSIN HAROLD H. KOLB S-187 LAKE GENEVA, WIS LAND SURVEYOR

SCALE: 1"=40'

ø - IRON PIPE FOUND
o - IRON PIPE PLACED
( ) - RECORDED AS

I, HAROLD H. KOLB, DO HEREBY CERTIFY THAT I HAVE SURVEYED THE PROPERTY HEREON DESCRIBED ACCORDING TO THE OFFICIAL RECORDS, AND THAT THE PLAT HEREON IS A CORRECT REPRESENTATION OF THE LOT LINES TO THE BEST OF MY KNOWLEDGE AND BELIEF.

Harold H. Kolb

HAROLD H. KOLB
WISCONSIN REGISTERED LAND SURVEYOR, S-187

DATE Oct. 5, 1992

ROP-193

7-714-K