
KOLB LAND CONSULTING, INC.

LAND SURVEYING · SUBDIVIDING · LAND PLANNING

LAKE GENEVA, WISCONSIN 53147 WHITEWATER, WISCONSIN 53190

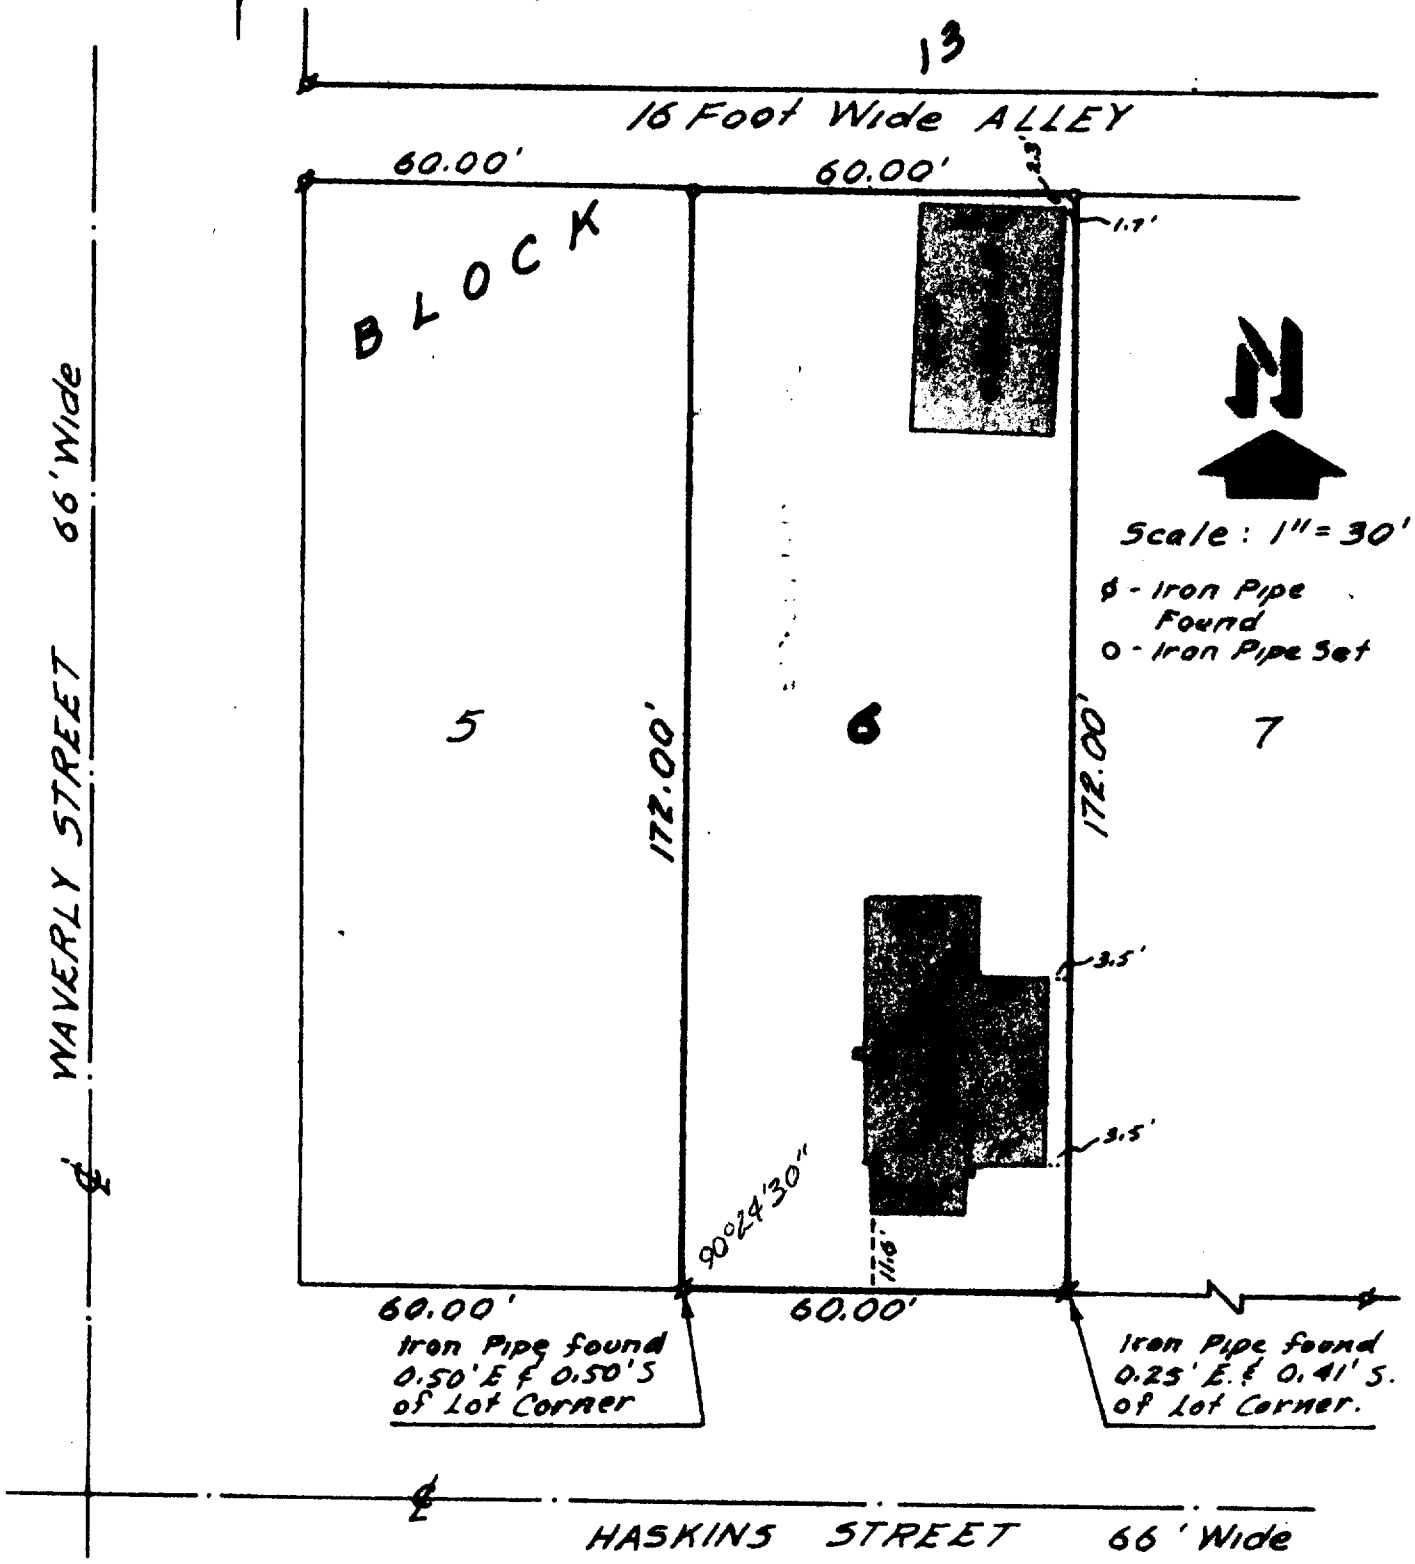

PLAT OF SURVEY OF

LOT 6, BLOCK 13, GENEVA LAKE CRAWFORD MANUFACTURING COMPANY ADDITION TO THE CITY OF LAKE GENEVA, WALWORTH COUNTY, WISCONSIN.

I, HAROLD H. KOLB, DO HEREBY CERTIFY THAT I HAVE SURVEYED THE PROPERTY HEREON DESCRIBED ACCORDING TO THE OFFICIAL RECORDS, AND THAT THE PLAT HEREON IS A CORRECT REPRESENTATION OF THE LOT LINES AND THE PRINCIPLE LINES OF THE BUILDINGS THEREON.

WISCONSIN HAROLD H. KOLB S-187 LAKE GENEVA LAND SURVEYOR

Harold H. Kolb

WISCONSIN REGISTERED LAND SURVEYOR, S-187

DATE OCTOBER 5, 1982

ZGC-52

7-715-K ✓