
(55-4)

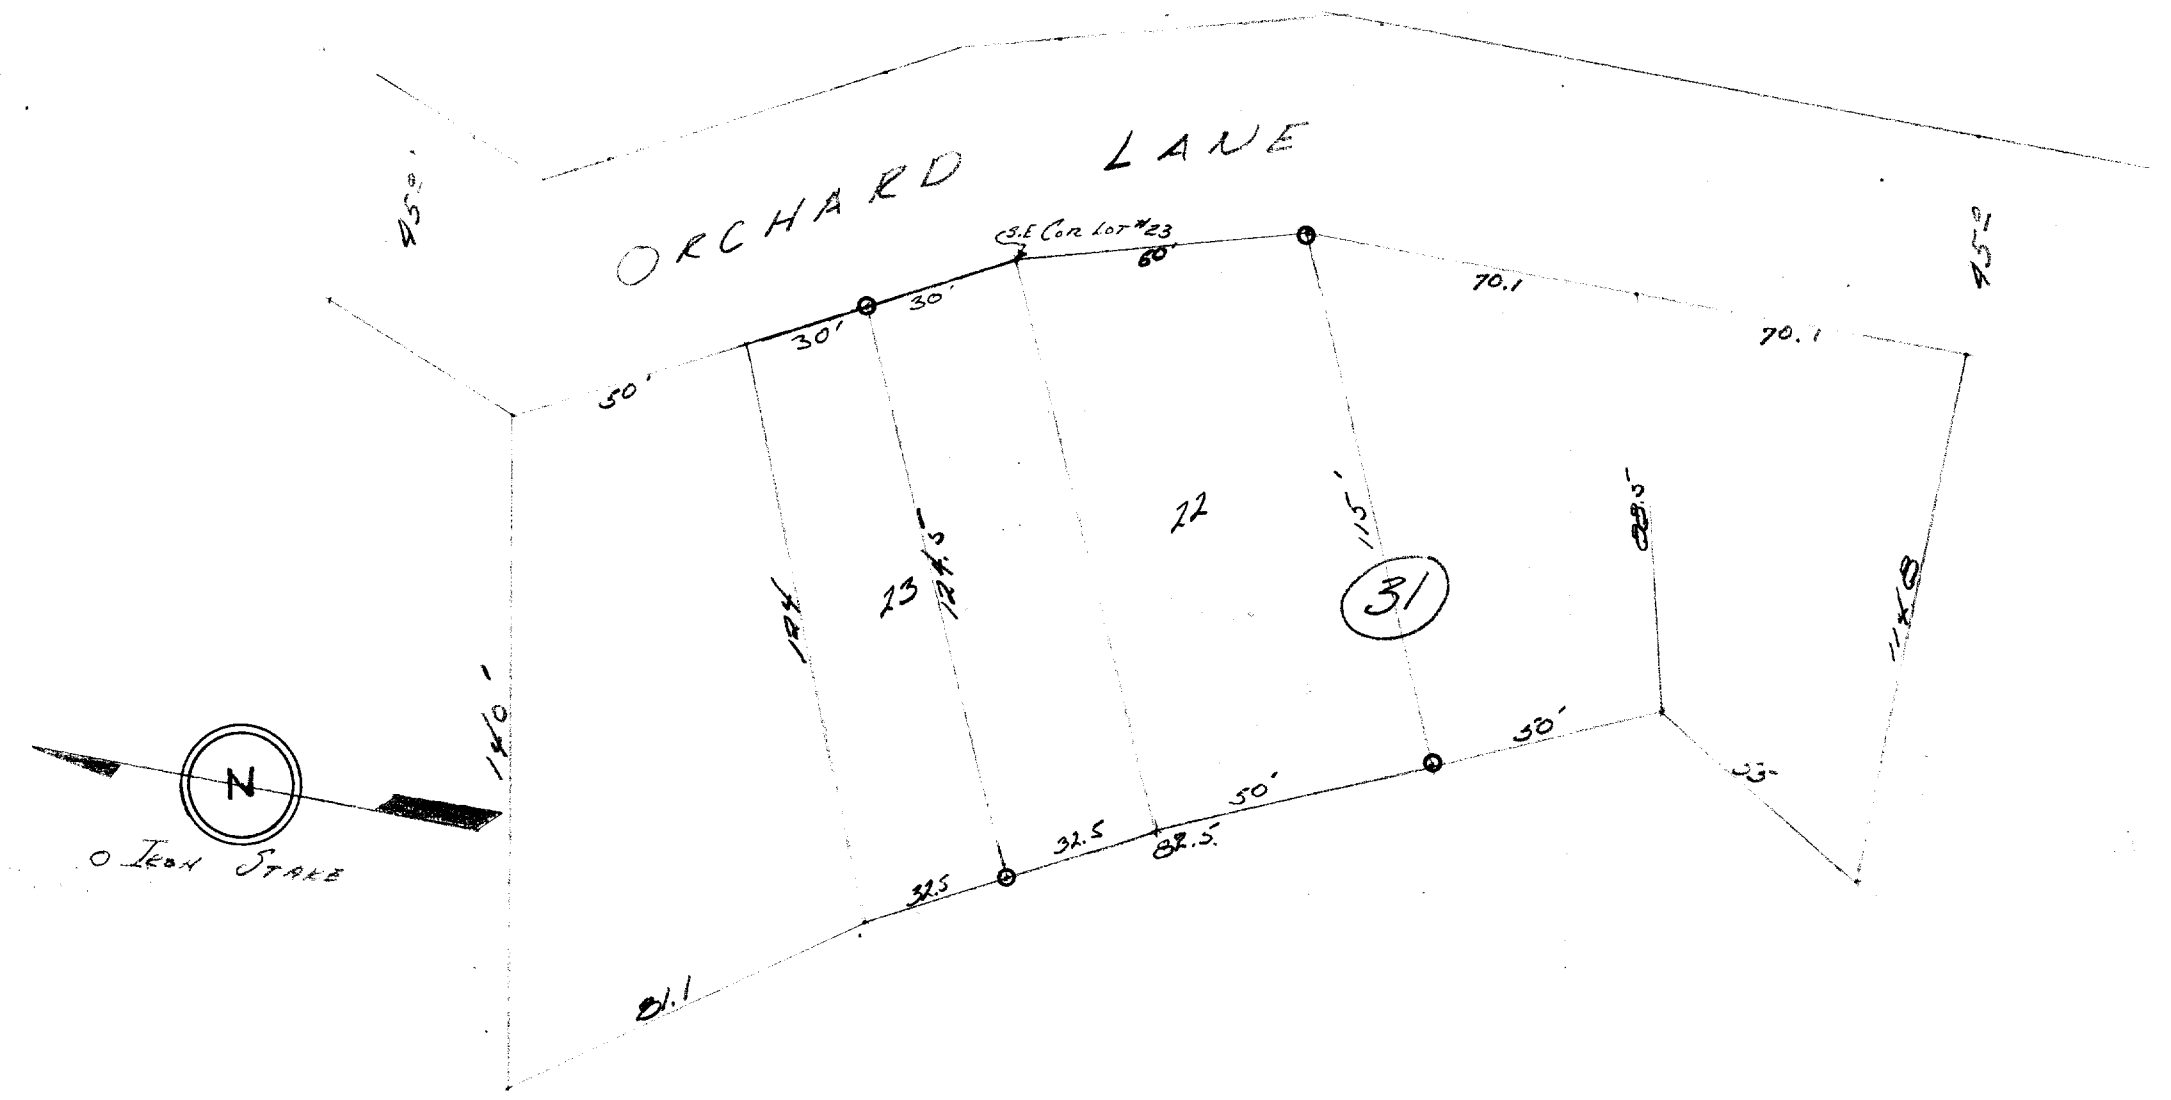

DESCRIPTION:

Lot 22 of Block 31 and the southwesterly one half of Lot 23 of Block 31, said one half of Lot 23 being more specifically described as follows to-wit: Commencing at the southeast corner of Lot 23 in Block 31, thence **northwesterly** to the southwest corner of said Lot 23, thence northeasterly along the northwesterly border of said Lot 23, thirty-two and one-half 32.5 feet, thence southeasterly parallel with the southwest border of said Lot 23, to the southeast border line fronting Orchard Lane of the said Lot 23, thence along the southeast border of said Lot 23 to the place of beginning. All of the aforsaid lots being *part of Tract #17 of the Lake Geneva Manor as per plat recorded in the Office of the Recorder* of Deeds in and for Walworth County, Wisconsin.

CERTIFICATE:

I, hereby certify that I have on this the 22nd day of August, 1955, surveyed the above described property according to the official records on file in the office of the Recorder of Deeds in and for Walworth County, Wisconsin and find that no encroachments exist, and that the plat her displayed is a correct represenbation of said survey.

SIGNED AND SEALED ON THIS THE 26TH DAY OF AUGUST 1955.

Joseph M. Biagi. Professional Engineer
Elkhorn Wisconsin.

LM-80

7-710