FARRIS, HANSEN & ASSOCIATES, INC.

ENGINEERING, SURVEYING & LAND PLANNING

715 W. WALWORTH ST.-BOX 487-ELKHORN, WI.

PHONE: 414-723-2098

NORTH

SCALE: 1" = 20'

LEGEND

- SMALL EVERGREEN
- ○ 2" IRON PIPE FOUND
- ⌀ 1¼" IRON PIPE FOUND
- • IRON OBJECT AS INDICATED BY METAL LOCATOR
- ( ) RECORD DIMENSION

WORK ORDERED BY:

NESTOR C. ALABARCA
1760 HILLCREST DR.
LAKE GENEVA, WIS.

PLAT OF SURVEY OF

LOT 142 OF STURWOOD ADDITION NO. 8, CITY OF LAKE GENEVA, WALWORTH CO., WI.


I HEREBY CERTIFY I HAVE SURVEYED THE PROPERTY DESCRIBED HEREON AND THAT THIS PLAT IS A CORRECT REPRESENTATION THEREOF

WISCONSIN ROBERT A. FARRIS S-1293 ELKHORN, WIS. LAND SURVEYOR

Robert A. Farris

ROBERT A. FARRIS RLS

DATED THIS 23rd DAY OF JULY, 1982

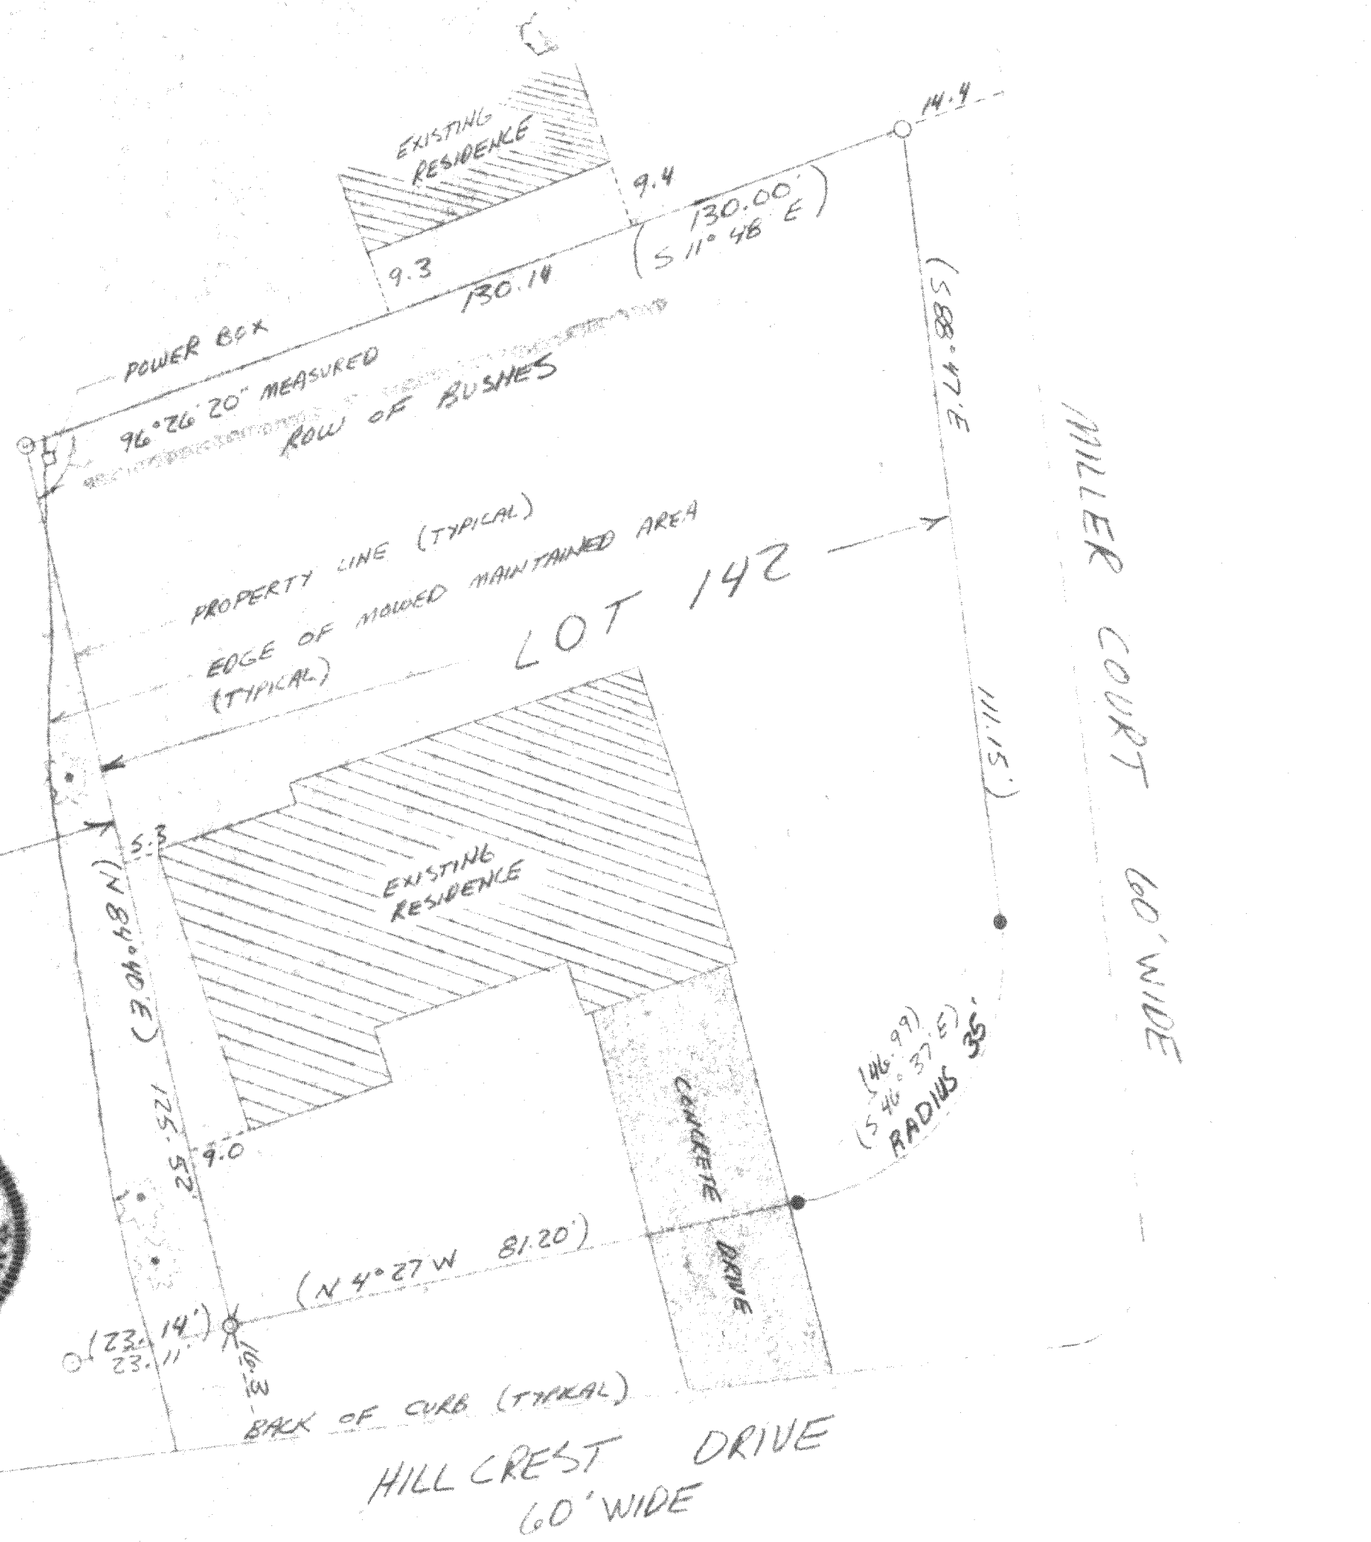

PROJECT # 1981

2ST 8-10

7-790-E