
KOLB LAND CONSULTING, INC.

LAND SURVEYING · SUBDIVIDING · LAND PLANNING

LAKE GENEVA, WISCONSIN 53147

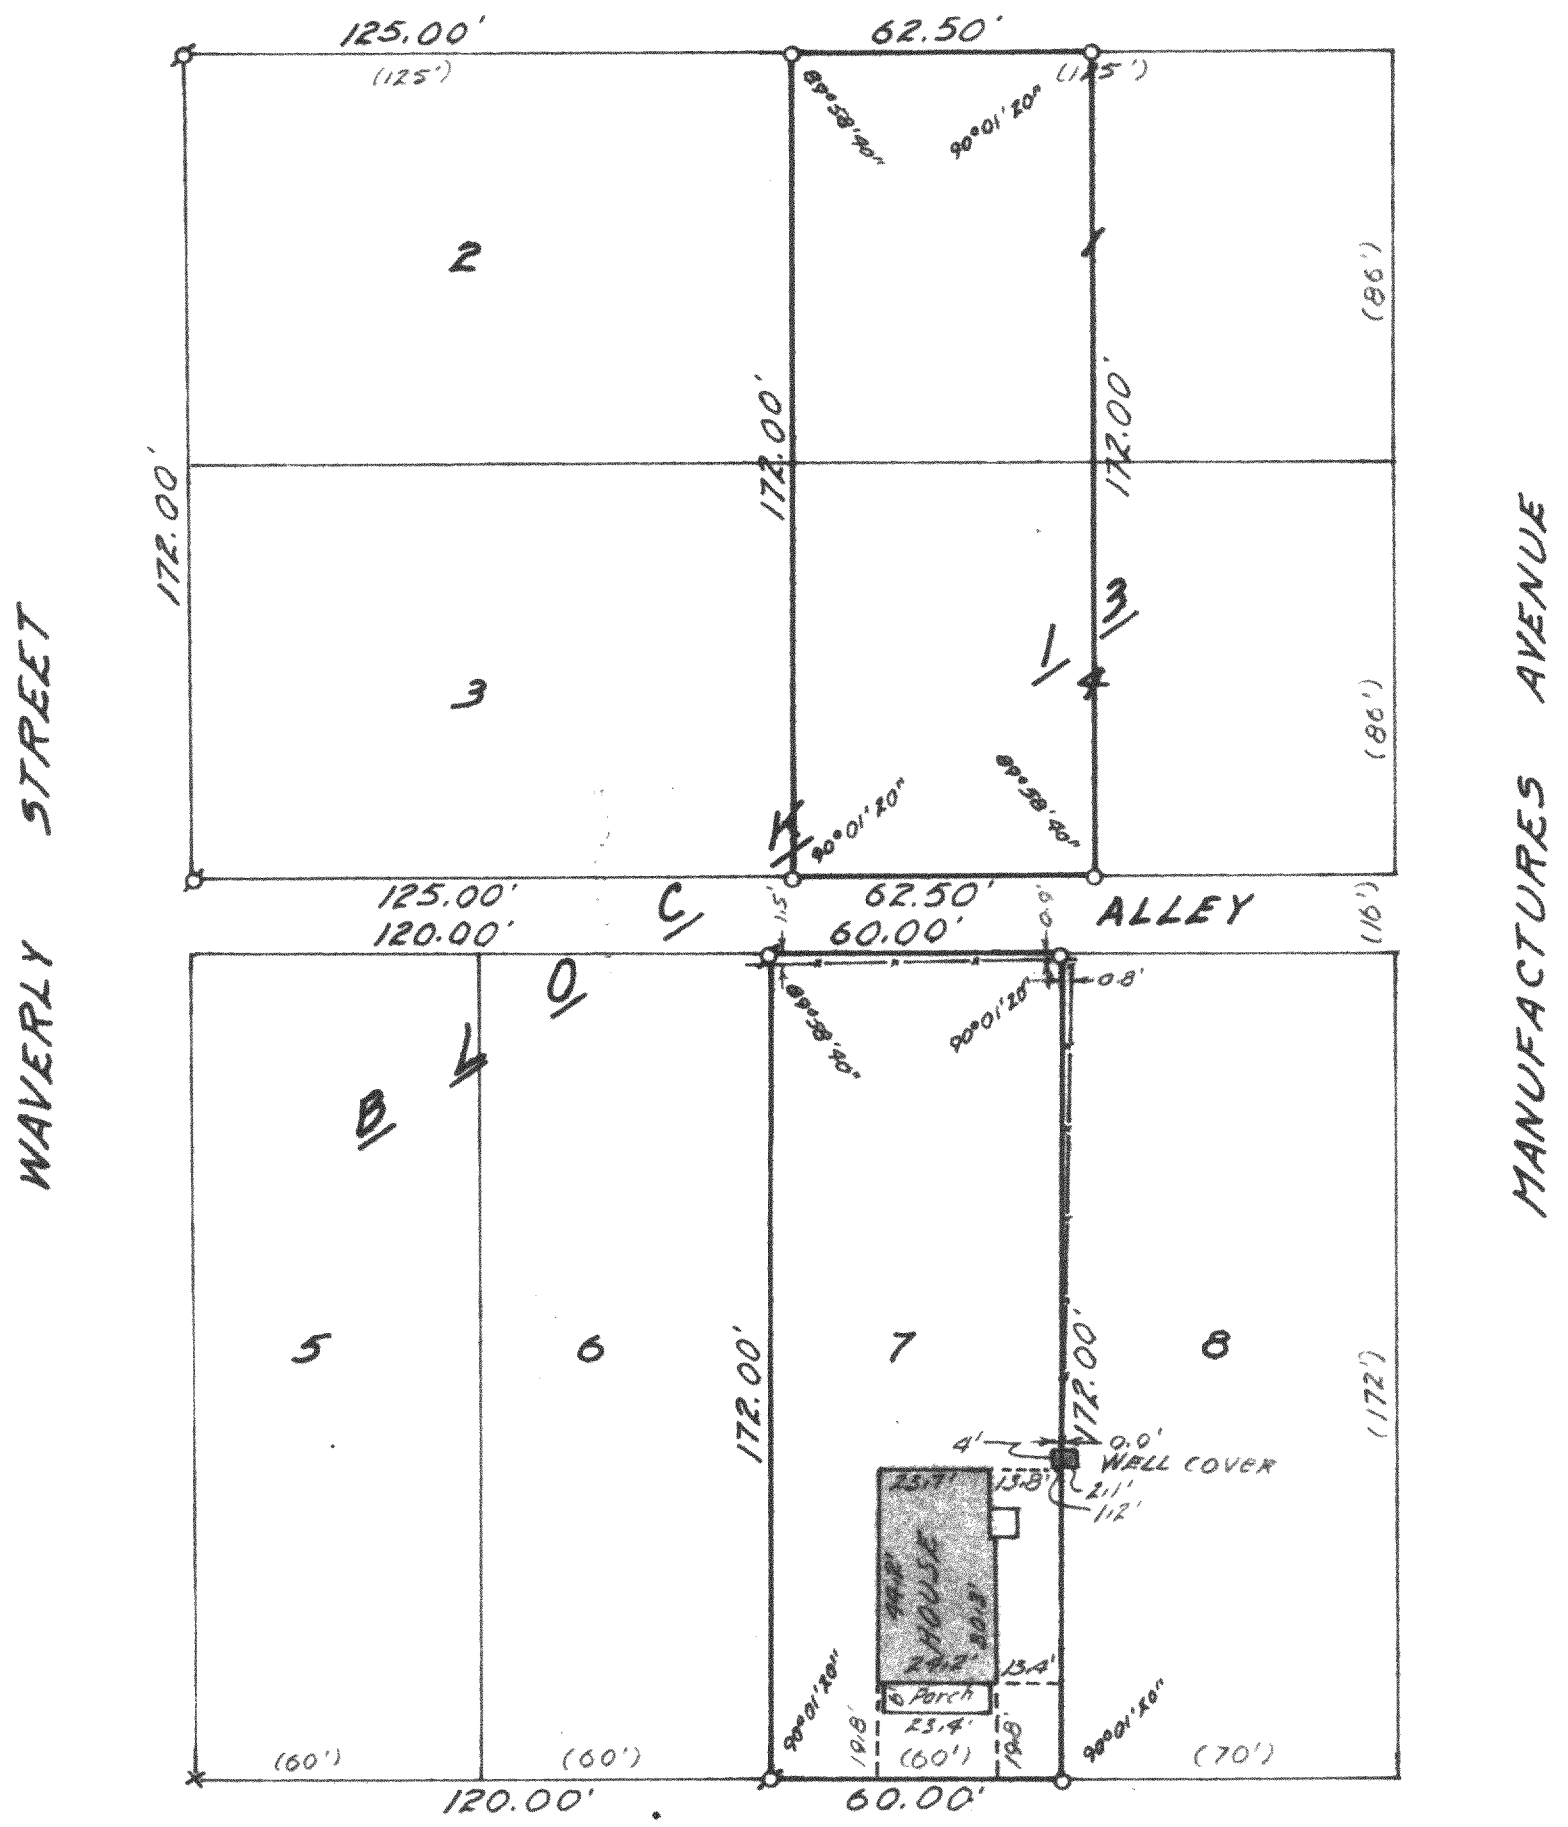

HASKINS STREET

PLAT OF SURVEY OF

LOT 7, BLOCK 13 AND THE WEST 1/2 OF LOTS 1 & 4, BLOCK 13, GENEVA LAKE CRAWFORD MANUFACTURING COMPANY ADDITION TO THE CITY OF LAKE GENEVA, WALWORTH COUNTY, WISCONSIN.

ORDERED BY: BETH TRUMAN

SCALE: 1"=40'

LEGEND
- ⌀ IRON PIPE FOUND
- O IRON PIPE SET
- (60') RECORDED DISTANCE
- × SPIKE

WISCONSIN HAROLD H. KOLB S-187 LAKE GENEVA, WIS. LAND SURVEYOR

I, HAROLD H. KOLB, DO HEREBY CERTIFY THAT I HAVE SURVEYED THE PROPERTY HEREON DESCRIBED ACCORDING TO THE OFFICIAL RECORDS, AND THAT THE PLAT HEREON IS A CORRECT REPRESENTATION OF THE LOT LINES AND THE PRINCIPAL LINES OF THE BUILDINGS THEREON TO THE BEST OF MY KNOWLEDGE AND BELIEF.

Harold H. Kolb

WISCONSIN REGISTERED LAND SURVEYOR, S- 187

DATE DECEMBER 7, 1982

GC-49 & GC-53

7-720-K