
KOLB LAND CONSULTING, INC.

LAND SURVEYING · SUBDIVIDING · LAND PLANNING

LAKE GENEVA, WISCONSIN 53147 WHITEWATER, WISCONSIN 53190

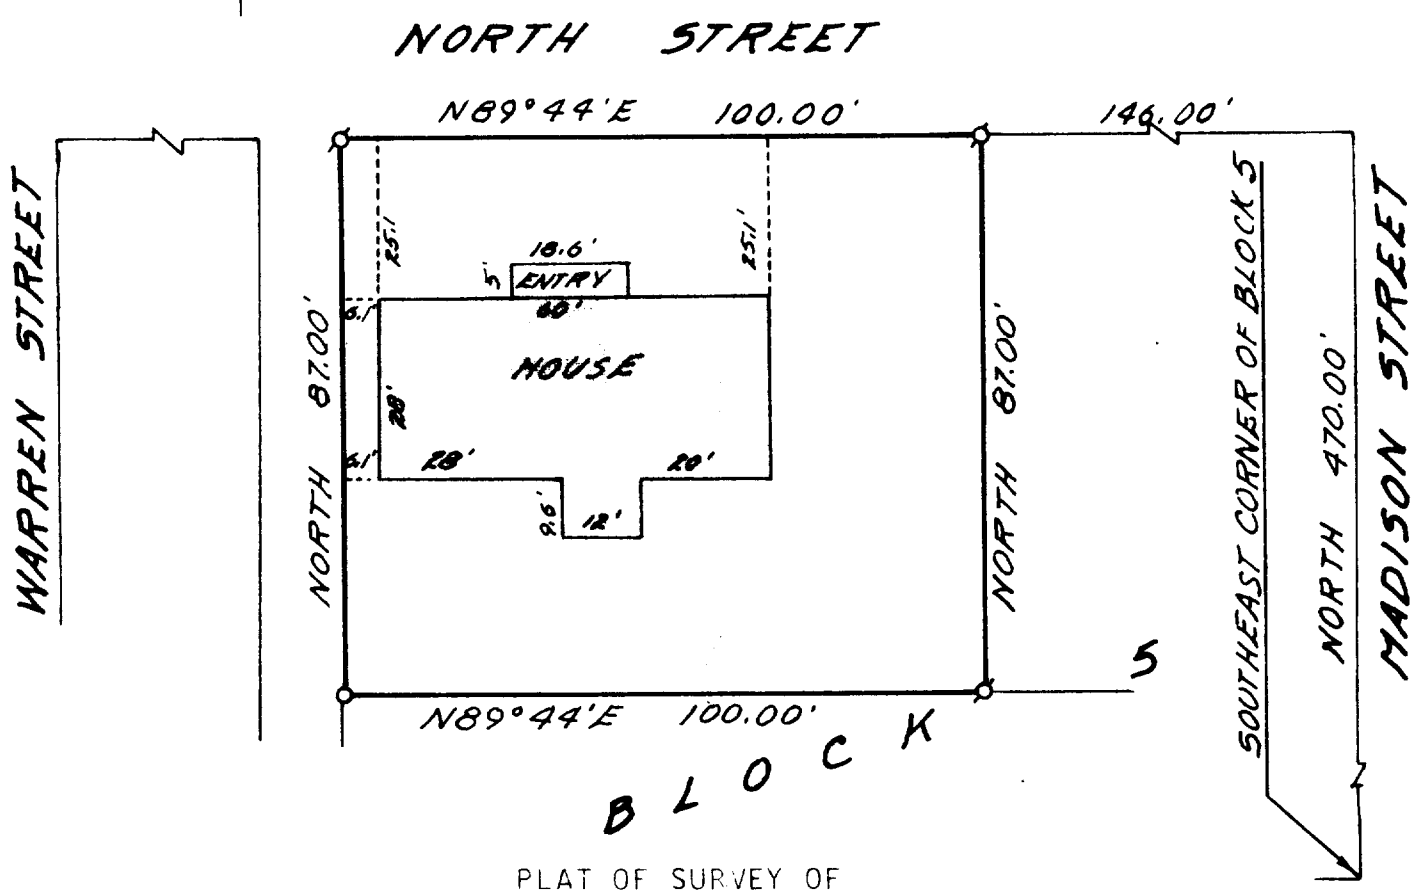

PLAT OF SURVEY OF

A PARCEL OF LAND LOCATED IN BLOCK 5 OF THE ORIGINAL PLAT OF THE CITY OF LAKE GENEVA, WALWORTH COUNTY, WISCONSIN AND DESCRIBED AS FOLLOWS:

COMMENCING AT THE SOUTHEAST CORNER OF SAID BLOCK 5; THENCE NORTH 470.00 FEET; THENCE S 89°44' W 146.00 FEET TO THE PLACE OF BEGINNING; THENCE CONTINUE S 89°44' W 100.00 FEET; THENCE SOUTH 87.00 FEET; THENCE N 89°44' E 100.00 FEET; THENCE NORTH 87.00 FEET TO THE PLACE OF BEGINNING.

ORDERED BY: JOHN LAW REALTORS

FOR: DUANE & DONNA HOVE

ADDRESS OF PROPERTY: 1020 NORTH STREET
LAKE GENEVA, WI. 53147

NOTE: BEARING ARE ASSUMED AS RECORDED.

SCALE 1"= 30'

LEGEND

ø IRON PIPE FOUND

o IRON PIPE SET-1¼ X 24"

I, HAROLD H. KOLB, DO HEREBY CERTIFY THAT I HAVE SURVEYED THA PROPERTY HEREON DESCRIBED ACCORDING TO THE OFFICIAL RECORDS, AND THAT THE PLAT HEREON IS A CORRECT REPRESENTATION OF THE LOT LINES AND THE PRINCIPAL LINES OF THE BUILDINGS THEREON TO THE BEST OF MY KNOWLEDGE AND BELIEF.

Harold H. Kolb

WISCONSIN REGISTERED LAND SURVEYOR, S- 187

DATE JANUARY 5, 1983

OP-34A

7-723-K