
DUNHAM SURVEYING, S. C.
SURVEYING & SUBDIVIDING
DELAVAN, WISCONSIN 53115

GROVE

STREET (unimproved)

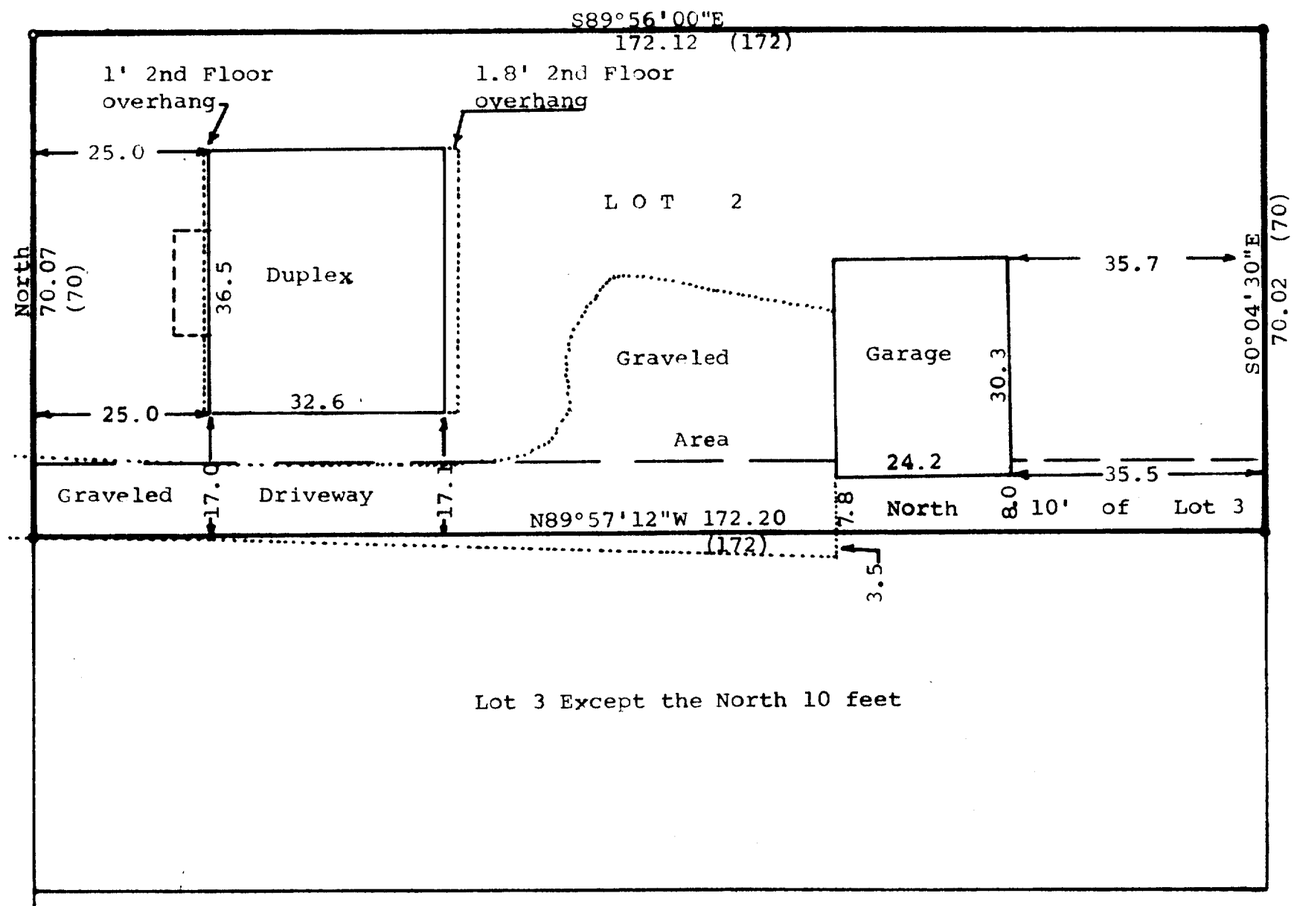

Lot 3 Except the North 10 feet

N

Scale - 1" = 20'
● = 3/4" Iron Rod Found
o = 3/4" Iron Pipe Found
Bearings referenced to the East line of Sage Street with the assumed bearing of North
Survey ordered by:
Robert A. Meyerhofer
Lake Geneva, WI 53147

STATE OF WISCONSIN)
COUNTY OF WALWORTH) SS

I, George T. Dunham, Surveyor, certify that I have surveyed the property described as follows:

Lot 2 and the North 10 feet of Lot 3, all in Block 8 of Geneva Lake Crawford Manufacturing Company Addition to the City of Lake Geneva, Walworth County, Wisconsin

and that the above map is a true representation thereof and shows the size and location of the property, its exterior boundaries, the location of all visible structures and dimensions of all principal buildings thereon, boundary fences, apparent easements, roadways and visible encroachments, if any, and that I have surveyed the property hereon described according to the official records, to the best of my knowledge and belief.

April 21, 1983

George T. Dunham, Surveyor

WISCONSIN
GEORGE T. DUNHAM
DELAVAN, WIS.
S-306
LAND SURVEYOR

26C-31

K & E 10-0155

7-724-D